


Section 15 Township 14 Range 13 W

Well No. # 3 Dumler

Company Duke & Wood

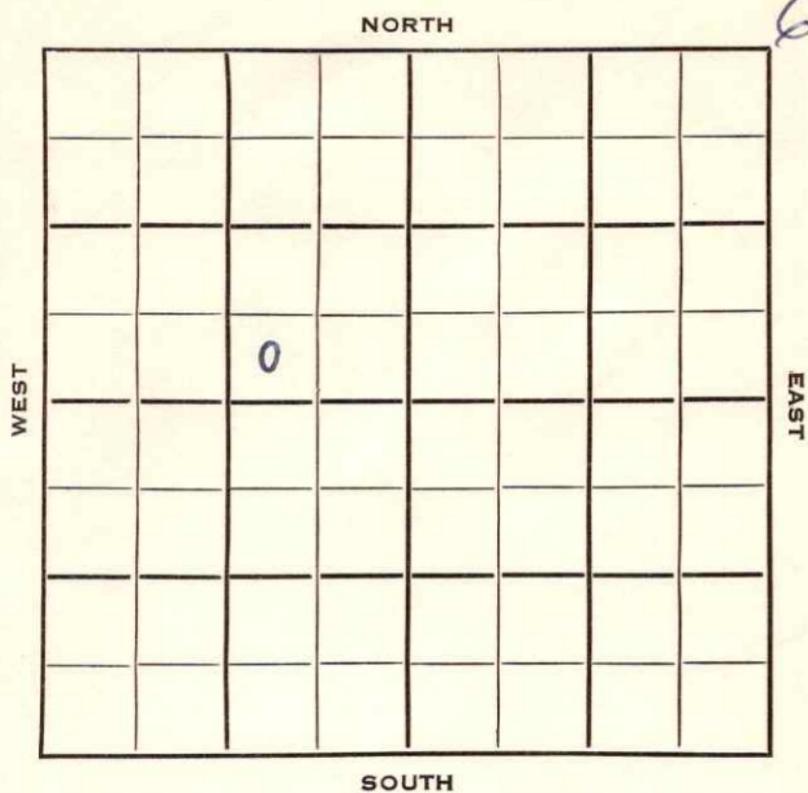

Russell

KANSAS


SEC.	TWP.	R.
15	14	13 W ₂

WELL NO. # 3 Dumler FARM

COMPANY Duke & Wood

CONTRACTOR Duke & Wood

_____ Ft. from N. Line
 330 _____ Ft. from S. Line
 990 _____ Ft. from E. Line
 _____ Ft. from W. Line

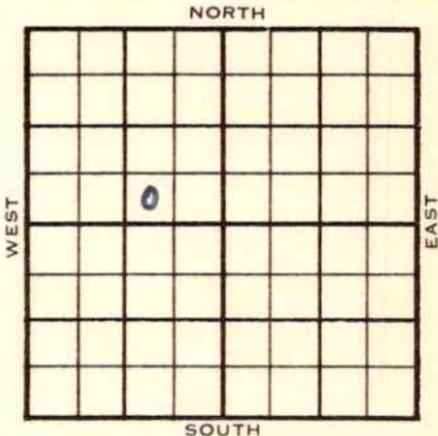

SW SE NW

	ELEVATION	REPORT
1953	1813'	
11/24	Spud 11-18-53 8" @ 233 Drlg. 1867'	Anhy 751'
12/22	Spud 11-18-53 Oil Well TD 2385' 8" @ 233' TD 2385' CO to 2369' 27/2356-59' Sd-oil-frac, 3 boph Comp. 25 bopd	Anhy 751', Grand Haven 2331', Tarkio 2357'

COMPLETED

