


Section 15 Township 14 Range 13W

Well No. #5 Dumler

Company Duke & Wood

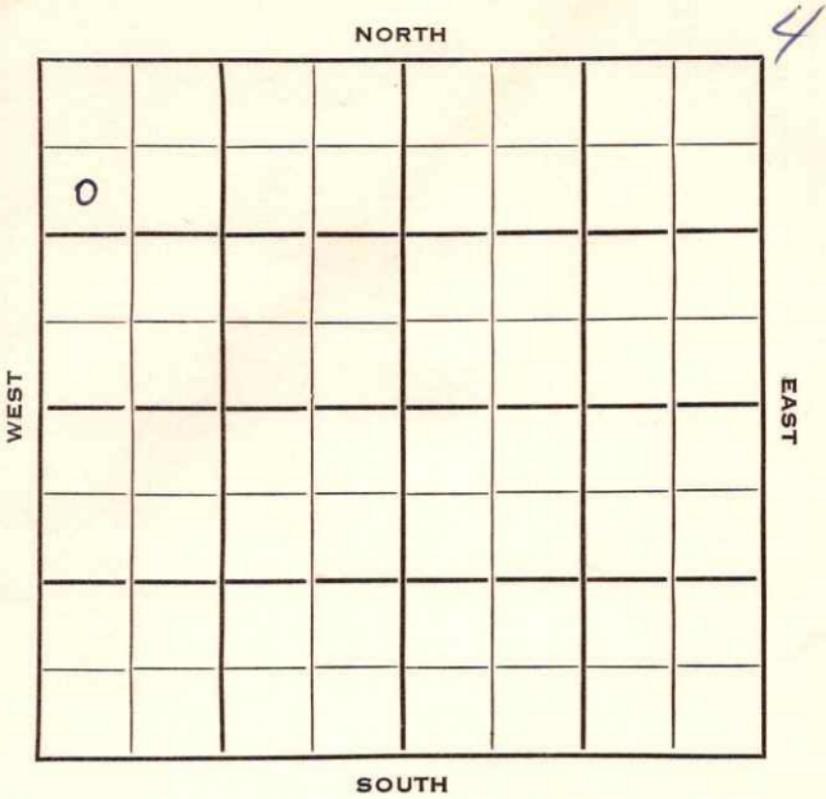

Russell

KANSAS

SEC.	TWP.	R.
15	14	13 W ✓

WELL NO. # 5 Dumler FARM

COMPANY

CONTRACTOR Duke & Wood


Duke & Wood
Hall-Gurney Pool

990 Ft. from N. Line

Ft. from S. Line

Ft. from E. Line

330 Ft. from W. Line

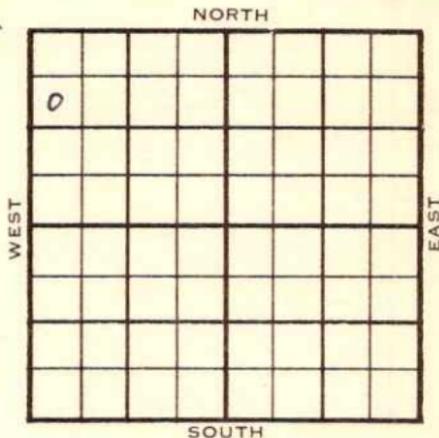

SW NW NW

	ELEVATION	REPORT
1954	1782'	

1/27 MIR

2/3 Spud 1-26-54 D & A TD 2357
 8" @ 234 Any 738 Tarkno 2345'
 TD 2357' D & A

ABANDONED

County Russell State KansasSec. 15 (Blk. 14 (Sur. 13W (Twp.) (Rge.) Map No.Operator Duke & WoodWell No. 5 Farm DumlerElev. _____ Location SW NW NW

o							

990 Ft. From N Line NW330 Ft. From W Line Quarter

JAN 27 1954

1st. Report _____

Completion _____

Remarks _____

Duke & Wood - Contr.

Spudding Date _____

Hell-Gurney Pool

Drlg. Data _____

M I R

