

Section 15 Township 14 Range 13WWell No. #1 HokeCompany Duke & Wood

NORTH

13

SOUTH


WEST

EAST

0

Sec. 15 Twp. 14 R. 13 WWell No. # 1 Hoke FarmDuke & Wood CompanyDuke & Wood Contractor Ft. from N. Line330 Ft. from S. Line Ft. from E. Line330 Ft. from W. Line

SW SW SW

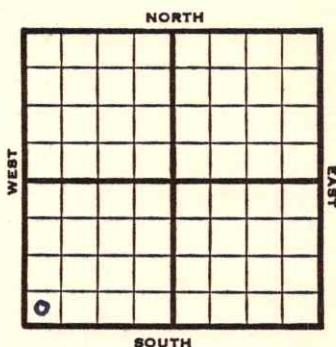

1953

Elev. 1836' REPORT

2/18

Location

2/26

8" @ 268 Anhy 778'

Drlg. 1920'

3/12

Tarkio 2358' TD 2490' 5" @ 2489
 CO 2480 12/2457-59 NS
 18/2361-64 10 GOPH sd-frac.

3/18

Spud 2-19-53

Oil Well

TD 2490

8" @ 268

Anhy 778, Tarkio 2358,

TD 2490

5" @ 2489

CO to 2480

12/2457-59, 18/2361-64,

10 goph sd-frac, 5 boph

S/9 boph

Comp. 30 bopd

COMPLETED

County Russell State KansasSec. 15 (Blk.) 14 (Sur.) 13W Map No.Operator Duke & WoodWell No. 1 Farm HokeElev. Location SW SW SW330 Ft. From S Line SW330 Ft. From W Line Quarter1st. Report FEB 18 1953

Completion

Remarks

Duke & Wood - Contr.

Spudding Date

Drlg. Data

Location

County Russell State Kansas
 Sec. 15 (Blk. 14) (Sur. 13W) Map No. _____
 Operator Duke & Wood
 Well No. 1 Farm Hoke
 Elev. 1836 Location SW SW SW



330 Ft. From S Line SW
330 Ft. From W Line Quarter
 1st. Report _____
 Completion MAR 18 1953
 Remarks _____
Duke & Wood - Contr.
 Spudding Date 2-19-53

Drlg. Data Oil well TD 2490
8" @ 268 Anhy 778 Tarkio 2358
TD 2490 5" @ 2489 CO to 2480
12/ 2457-59 18/ 2361-64 10 goph
sd-frac 5 boph S/ 9 boph
Comp. 30 bopd

J. G. McGEHEE