


Section 19 Township 14 Range 13 W

Well No. # 13 Ehrlich

Company CR A

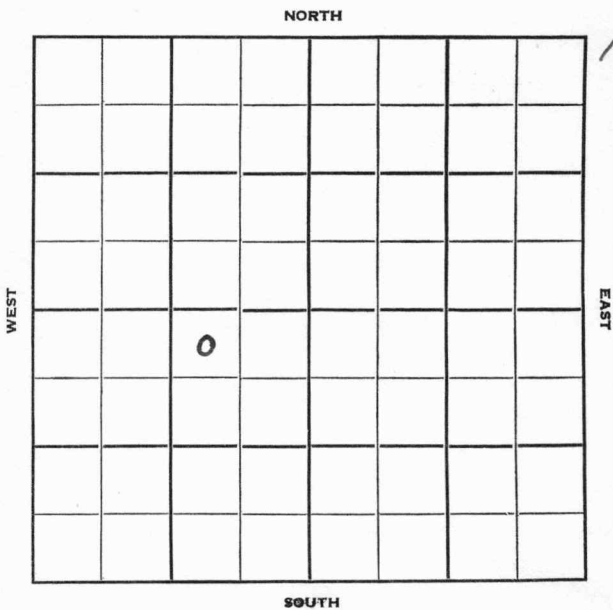

Sec. 19 Twp. 14 R. 13 W

Well No. # 13 Ehrlich Farm

C R A Company

Sunflower Drlg. Contractor


330 Ft. from N. Line

Ft. from S. Line

990 Ft. from E. Line

Ft. from W. Line

NW NE SW

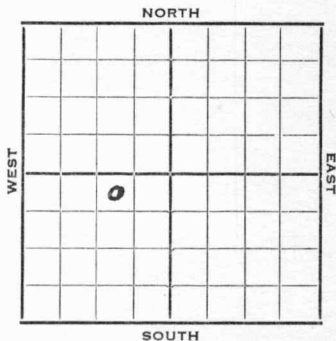

1952 Elev. 1781' REPORT

6/11 Location
 6/18 "
 6/25 "
 7/2 8" @ 221
 1st Tarkio 2300 2nd Tarkio 2315-19
 RTD 5" @ 2316
 7/9 DD 2325 SO DD 2329 TD B/3 galoph
 & 1 galw D-Hyd S/49 BO 15 hrs.
 7/16 Spud 6-24-52
 Oil well TD 2329' 8" @ 221
 1st Tarkio 2300' 2nd Tarkio 2315'
 5" @ 2316 TD 2325' DD 2329'
 B/3 GOPH 1 GW D-Hydro.
 S/49 BO 15 hr.
 Comp. 47 BOPD 5 BW

COMPLETED

