


Section 15 Township 14 Range 13W

Well No. #3 Hoke

Company Duke & Wood

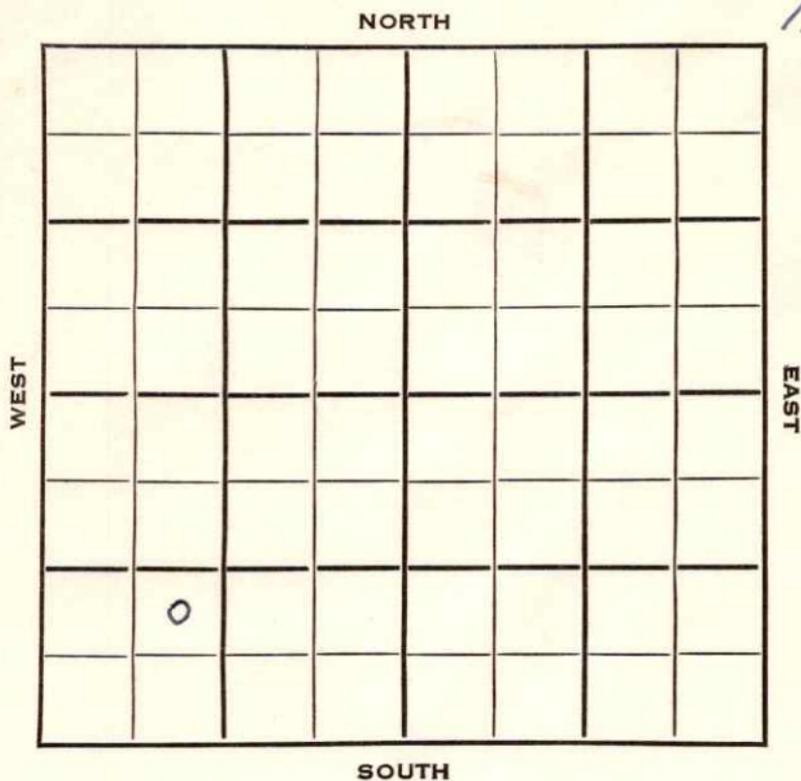

Sec. 15 Twp. 14 R. 13WWell No. #3 Hoke FarmDuke & Wood Company

Contractor


Ft. from N. Line

990 Ft. from S. Line

Ft. from E. Line

990 Ft. from W. Line

NE SW SW

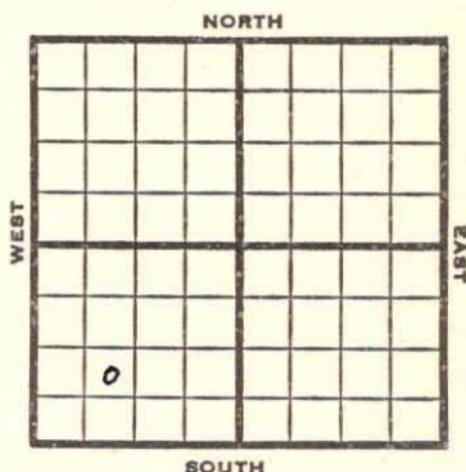1953 **Elev. 1781'** REPORT

- 8/19 Spud 8-14-53
8" @ 233'
Anhy 724'
- 8/26 Drlg 1905'
Tarkio 2302
TD 2335'
5" @ 2335'
- 9/2 N.R.
- 9/9 CO 2318, 47/2303-06 $\frac{1}{2}$, S/2 boph 10 hrs.
Sd-o-frac
FU 1300' oil + 100' wtr, 14 hrs.
- 9/16 Spud 8-14-53 Oil well TD 2335'
8" @ 233' **Anhy 724' Tarkio 2302**
TD 2335 5" @ 2335 CO to 2318
47/2303-06 S/2 BOPH 10 hr.
Sd-oil-frac. FU 1300' oil 100' wtr.
14 hr. S/3-3/4 BOPH 25% wtr.
Comp. 25 BOPD 25% wtr.

COMPLETED

