

Sec. 15 Twp. 14 R. 13 W

Well No. # 4 Hoke Farm _____

Duke & Wood Company _____

Duke & Wood Contractor _____

Hall-Gurney Pool


_____ Ft. from N. Line

990 Ft. from S. Line

_____ Ft. from E. Line

330 Ft. from W. Line

NW SW SW

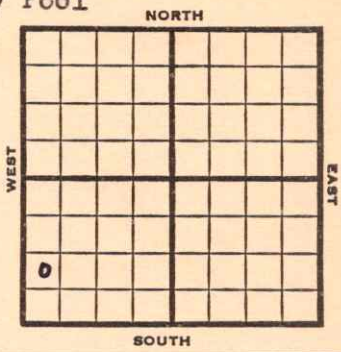

1953 **Elev. 1788'** REPORT

9/2 Spud 8-27-53
8" @ 230 **Anhy 736**
Drlg. 1900'

9/9 NR

9/16 **Tarkio 2313'** RTD 2350' 5" @ 2350
CO 2550 44/2314-17 S/3/4 BOPH
& 1/4 BW Sd-frac.

9/23 Spud 8-27-53
Oil Well
TD 2350'
8" @ 230'
Anhy 736', Tarkio 2313'
TD 2350'
5" @ 2350'
CO to 2350'
44/2314-17
S/ 3/4 boph 1/4 bw
sd-frac
S/1 boph
Comp. 25 bopd

COMPLETED

