


Section 15 Township 14 Range 13W

Well No. 4 Dumler

Company Duke & Wood

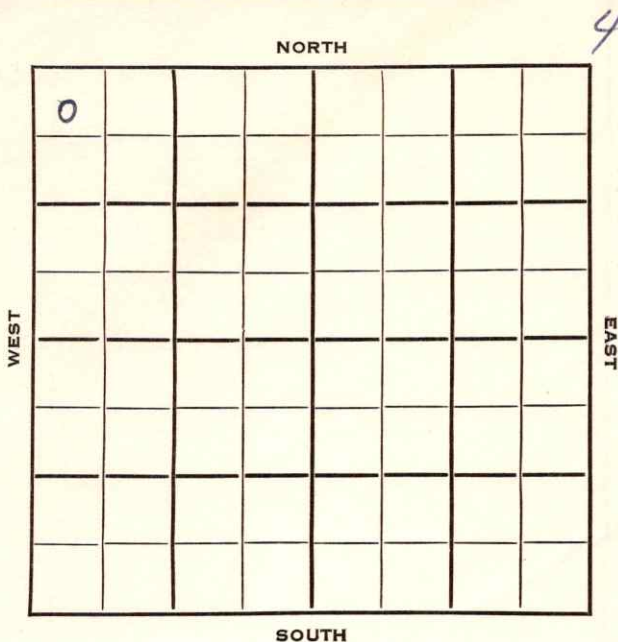

Russell

KANSAS

SEC.	TWP.	R.
15	14	13W

WELL NO. #4 Dumler FARM

COMPANY Duke & Wood

CONTRACTOR


Hall-Gurney Pool

330 Ft. from N. Line

Ft. from S. Line

Ft. from E. Line

330 Ft. from W. Line

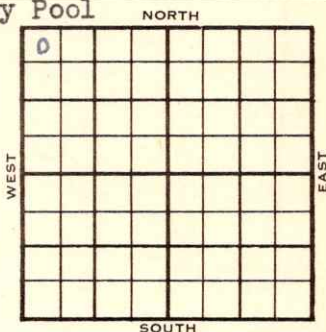

NWNW NW

1954	ELEVATION 1787'	REPORT
------	--------------------	--------

1/20 Location
 1/27 8" @ 239 Anhy 750' Tarkio 2331'
 RTD 2375' 5" @ 2375'
 2/3 NR
 2/10 NR
 3/3 Spud 1-20-54
 Oil Well
 TD 2375'
 8" @ 239'
 Anhy 750', Tarkio 2331'
 TD 2375'
 5" @ 2375'
 58/2333-40', 12 go 7 gw
 frac, S/1 boph
 Comp. 20 bopd 10 bw

COMPLETED

County Russell State Kansas

Sec. 15 (Blk. 14 (Sur. 13W (Twp.) (Rge.) Map No.

Operator Duke & Wood

Well No. 4 Farm Dunler

Elev. _____ Location NW NW NW

0					

330 Ft. From N Line NW

330 Ft. From W Line Quarter

1st. Report JAN 20 1954

Completion _____

Remarks _____

Spudding Date _____

Drlg. Data Hall-Gurney Pool

Location

County Russell State KansasSec. 15 (Blk.) 14 (Sur.) 13W Map No.Operator Duke & WoodWell No. 4 Farm DumlerElev. 1787 Location NW NW NW

o					

330 Ft. From N Line NW330 Ft. From W Line Quarter

1st. Report _____

Completion MAR 3 1954Remarks Hall-Gurney PoolSpudding Date 1-20-54Drig. Data Oil well TD 23758" @ 239 Anhy 750 Tarkio 2331TD 2375 5" @ 2375 58/ 2333-4012 go 7 gw frac S/ 1 bophComp. 20 bopd. 10 bw