


Section 15 Township 14 Range 13W

Well No. 1 Hoke

Company Murfin Drlg

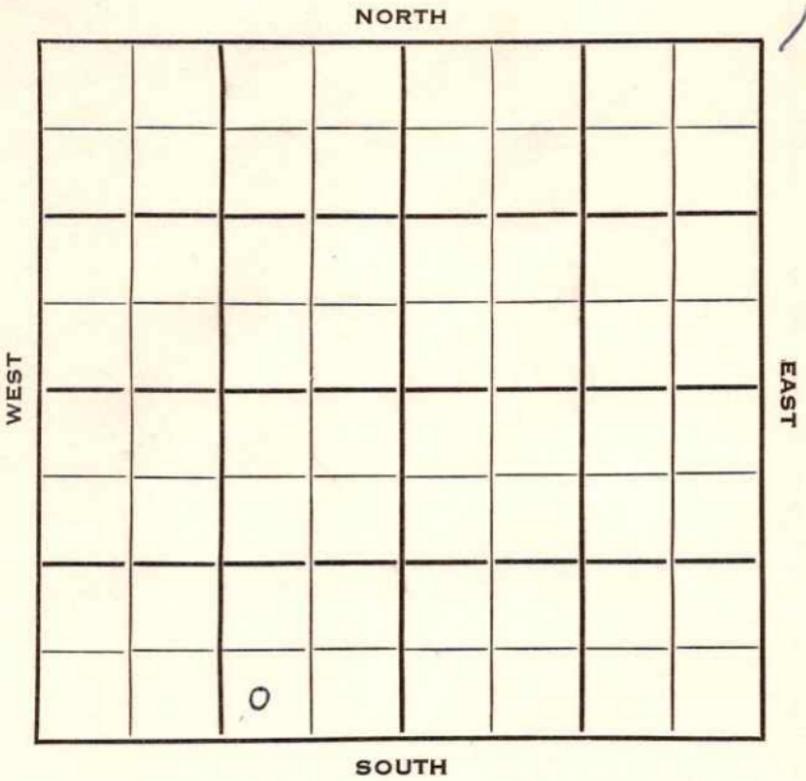

Russell

KANSAS

Sec. 15 Twp. 14 R. 13 W

Well No. # 1 Hoke Farm

Murfin Drlg. Company

Murfin Drlg. Contractor


Ft. from N. Line

330 Ft. from S. Line

990 Ft. from E. Line

Ft. from W. Line

SW SE SW

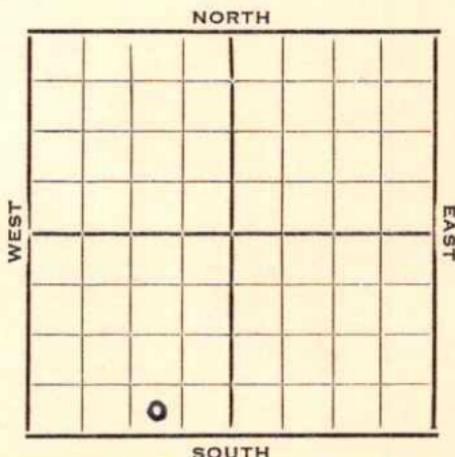

1953

Elev. 1772'

REPORT

4/8

Spud 4-7-53

4/16

13" @ 278
Drlg. 280'

4/23

Anhy 707'
8" @ 713
Drlg. 1440'

4/30

Tarkio 2287
Drlg. 2300

5/7

TD 2319 7" @ 2288 CO 2294
FU 150' oil B/1 1/2 BOPH 8 hrs.

5/13

Spud 4-7-53
Oil Well
TD 2319'
13" @ 278'
Anhy 707'
8" @ 713'
Tarkio 2287,
TD 2319
7" @ 2288'
CO to 2294 FU 150' oil B/ 1 1/2 boph
8 hr CO to 2296 7 1/2 goph 8 hr. sd-frac
Comp. 25 bopd.

COMPLETED

