


Section 15 Township 14 Range 13 W

Well No. # 2 Hoke

Company Duke & Wood

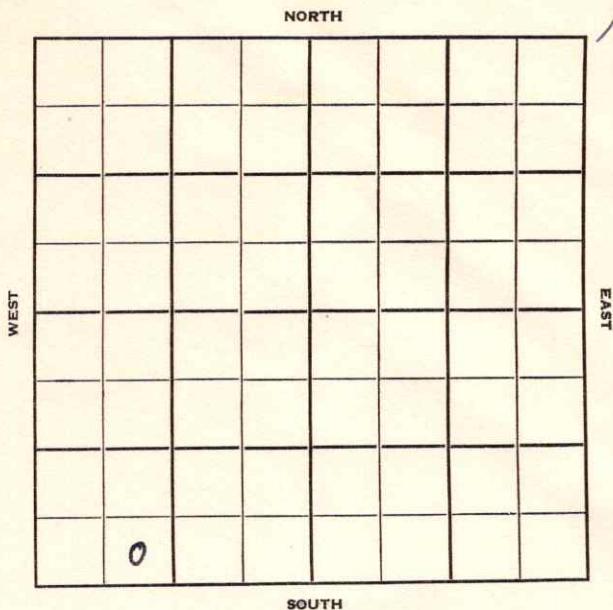

Russell

Sec. 15 Twp. 14 R. 13W

Well No. #2 Hoke Farm _____

Duke & Wood Company _____

Duke & Wood Contractor _____

Hall-Gurney Pool


_____ Ft. from N. Line

330 Ft. from S. Line

_____ Ft. from E. Line

990 Ft. from W. Line

SE SW SW

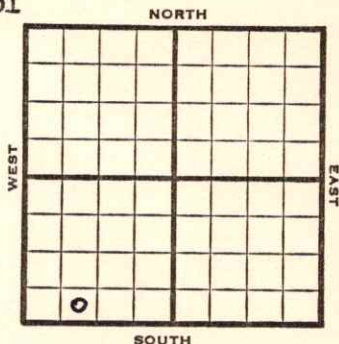

1953 **Elev. 1803'** REPORT

5/20 Spud 5-15-53
8" @ 234
Drlg. 1203'

5/28 N.R.

6/3 N.R. 1215'

6/17 Spud 5-15-53
Oil Well
TD 2360'
8" @ 234'

Tarkio 2320

TD 2360'

CO to 2344'

59/ 2322-26 FU 1200' oil 12 hr.

sd-oil-frac. 2 boph

Comp. 50 bopd.

COMPLETED

County **Russell** State **Kansas**Sec. **15** (Blk. Twp.) **14** (Sur. Rge.) **13W** Map No.Operator **Duke & Wood**Well No. **2** Farm **Hoke**Elev. Location **SE SW SW**

330 Ft. From **S** Line **SW****990** Ft. From **W** Line Quarter1st. Report **MAY 20 1953**

Completion

Remarks

Duke & Wood - Contr.Spudding Date **5-15-53**Drlg. Data **Hall-Gurney Pool****8" @ 234 drlg. 1203**

