Russell


KANSAS

SECTION 19 TOWNSHIP 14 RANGE 13W

WELL NO. #15 Ehrlich

COMPANY CRA

NORTH C S½ S½ SE 16

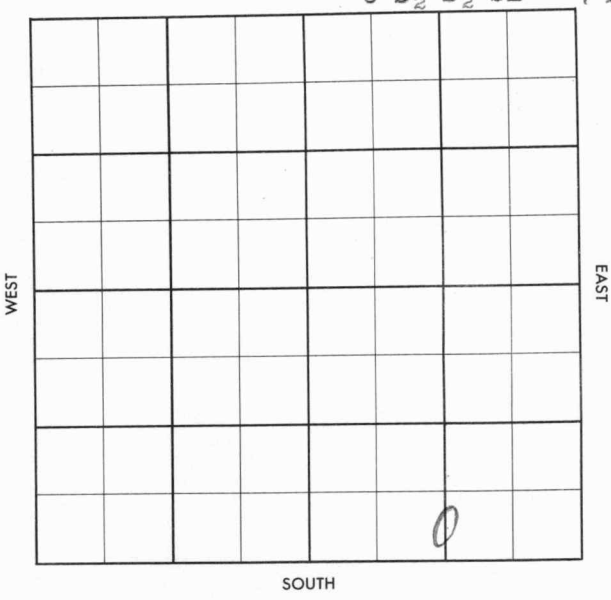

FORM 504-3 SUNRAY

FORM 513 SUNRAY

County Russell Elev.

Sec. 19 Twp. 14 Rge. 13W

Company C R A

Farm Name Ehrlich No. 15

TOPS	DEPTH	LOG	DATUM
Anh.			
Tp.			
H.			
Tr.			
Dg.			
Bl.			
L.			
K.C.			
B.K.C.			
Ce.			
C.			
M.			
M.			
K.			
Mz.			
Mo.			
V.			
S.			
S.			
A			
R.			
Pe.			
G.			
T.D.			

Loc. in Sec. C S½ S½ SE

Geol.

Contr. Shields

Pool Hall-Gurney

FIRST REPORT

JUL 17 '57

Date Comm. 7-13-57

8" @ 708/400 drlg.

13

Co. Lse. No. Sec. T. R.

FORM 513 SUNRAY

1750 DF

County Russell — Elev. 1752 RB — Co.

Sec. 19 — Twp. 14 — Rge. 13W

Company C R A

Farm Name Thrlich — No. 15

TOPS	DEPTH	LOG	DATUM
Anh. Tark	2272		
Tp. Tark Ls	2310		
H. Elm.	2378		
Tr. Tp	2584		
Dg. Hs	2816		
Bl. Tr	2834		
L.	2882		
K.C.			
B.K.C.			
Ce.			
C.			
M.			
M.			
K.			
Mz.			
Mo.			
V.			
S.			
S.			
A			
R.	3155		
P€.			
G.			
T.D.	3157		

Loc. in Sec. C S½ S½ SE

Geol.

Contr. Shields — Lse.

Pool Hall-Gurney

AUG 21 '57

COMPLETE — No.

Date Comm. 7-13-57 — Sec.

8" @ 708/600 drlg. JUL 24 '57 Rng 5½

~~@ 3156~~ JUL 31 '57 @ 3155½ /125' CO T.

3157 no Fluid DD 3173 no show

PB 3110 42/3070-77 ✗ scum oil

+3 BWPH /3 ✗ 2,25 PO in R.

2hrs PB 3010 /40/2924-82

✗ no oil + 46 WPH 40/2918-28

20/2904-09 no inc 28/2985

-92 N.S. Total /8 ✗ 153.76

FORM 513-1 SUNRAY

BF in 8 hrs 15% oil & 40 BO + 80 BW 24 hrs POP @ 25 BO + 45 BWPD

19-14-13W CS/25/2 RL