


Section 15 Township 14 Range 13W

Well No. 4 Hoke "A"

Company Murfin Drlg.

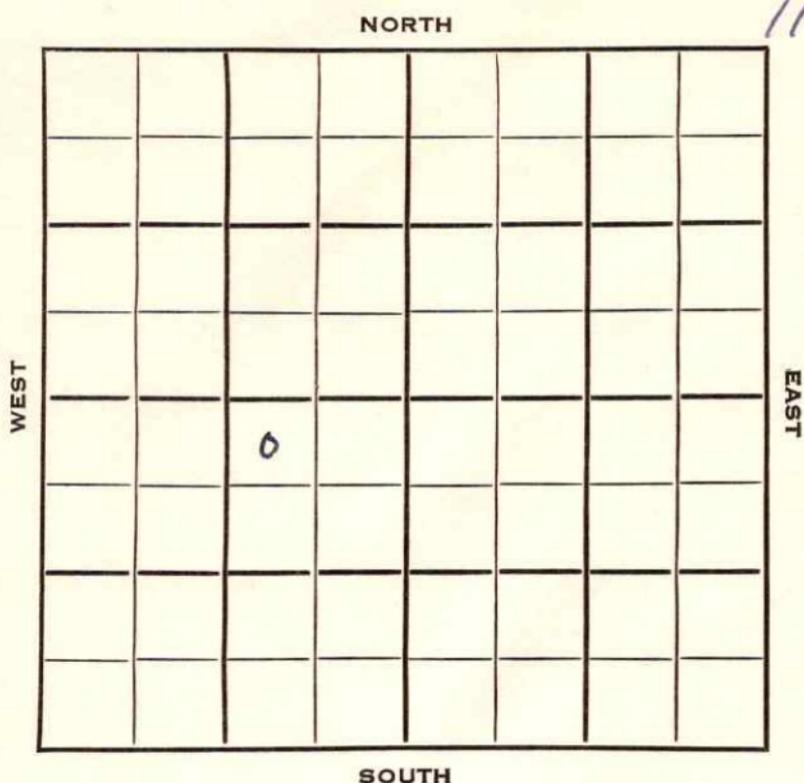


SEC.	TWP.	R.
15	14	13W

WELL NO. #4 Hoke "A" FARM

COMPANY Murfin Drlg.
CONTRACTOR

Hall-Gurney Pool

330 Ft. from N. Line
Ft. from S. Line
990 Ft. from E. Line
Ft. from W. Line

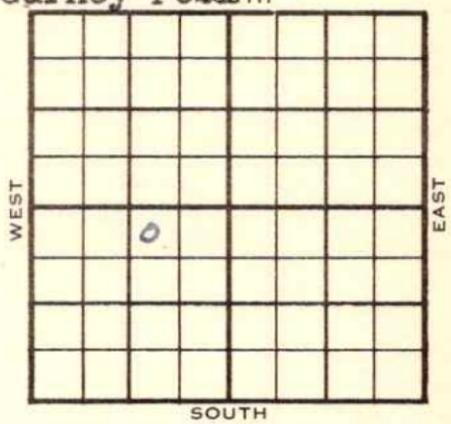

NW NE SW

	ELEVATION	REPORT
1954	1793'	

1/20 Spud 1-17-54
8" @ 158'
WOC

1/27 Tarkio 2322' RTD 2358' 5" @ 2358'

2/3 CO 2340 24/2325-31 St-frac.

2/10 Spud 1-17-54 Oil well TD 2358
8" @ 158 Tarkio 2322 TD 2358
5" @ 2358 CO to 2340 24/2325-31
Stfrac. 13 BOPH
Comp. 25 BOPD

COMPLETED

