

Section 19 Township 14 Range 13W

Well No. 1 Geo. Rein Jr.

Company Lindas Oil

Hall-Gurney^{NORTH}

5

WEST

EAST

0							

SOUTH

Sec. 19 Twp. 14 R. 13-W

Well No. #1 Geo. Rein Jr. Farm

Lindas Oil Company


Hall-Gurney Pool

Ft. from N. Line

330' Ft. from S. Line

Ft. from E. Line

330' Ft. from W. Line

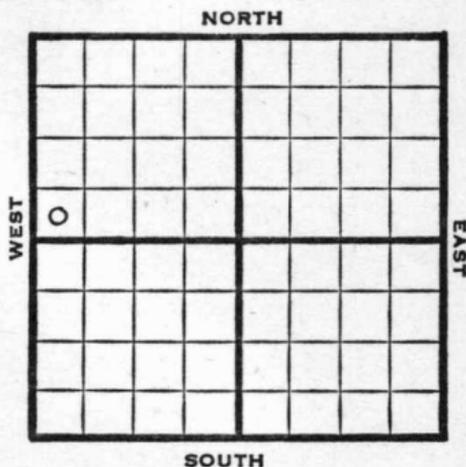

1947

Elev. 1775'

REPORT

11/12	Rig
11/19	"
11/25	"
12/3	"
12/10	"
12/17	"
12/30	15" @ 280' 10" @ 742' Drlg. 1400'
1948 1/7	Drlg. 1500'
1/14	Tarkio 2300' 8" @ 2300' SD Drlg 2323'
1/21	TD 3 1/2 bailers oil PH
1/26	"
2/4	"
2/11	20 qts. 2304'-17' CO
2/18	"
2/25	"
3/3	"

OVER

1948

3/10 20 qts. 2304-17' CO

3/17 "

3/24 "

3/31 "

4/7 "

4/14 Tarkio 2300'
8" @ 2300'
Pump 153 Pbt
41.0 Gr.
TD 2323'
Comp.

COMPLETED

Map No. _____ Sec. 19 Twp. 14 R. 13W

Well No. 1 Geo. Rein Jr.

Lindas Oil Company

FIRST REPORT Contractor

SW NW


SECTION PLAT

_____ Ft. from N. Line

330 Ft. from S. Line

_____ Ft. from E. Line

330 Ft. from W. Line

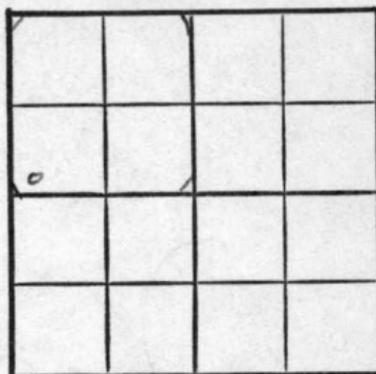

Russell County

Location _____

Rig up _____

Drilling and Remarks:

Rig

RECORD

Cased _____ in., _____ ft.

Sand _____

Gas _____

Oil _____

Total Depth _____

PRODUCTION

1st 24 hrs. Nat. _____

1st 24 hrs. after shot _____

Gas _____ Cu. Ft.

Dry Hole _____

Abandoned _____

Date

NOV 12 1947

19

S. J. LEWIS

Scout

Map No. 72 Sec. 19 Twp. 14 R. 13W

Well No. 1 Geo. Rein Jr.

Lindas Oil Company

COMPLETE

Contractor

SW NW

E. 1775
SECTION PLAT

6			

_____ Ft. from N. Line

330 Ft. from S. Line

_____ Ft. from E. Line

330 Ft. from W. Line

Russell County

Location _____

Rig up _____

Drilling and Remarks:

Tested 2000

8' @ 2800

Pump 1538 ft

410 ft

RECORD

Cased _____ in., _____ ft.

Sand _____

Gas _____

Oil

Total Depth 2323

PRODUCTION

1st 24 hrs. Nat. _____

1st 24 hrs. after shot _____

Gas _____ Cu. Ft.

Dry Hole _____

Abandoned _____

Date

APR 14 1948 19

S. J. LEWIS Scout