


Section 16 Township 14 Range 13W

Well No. #1 Chester Bear

Company Texas Co.

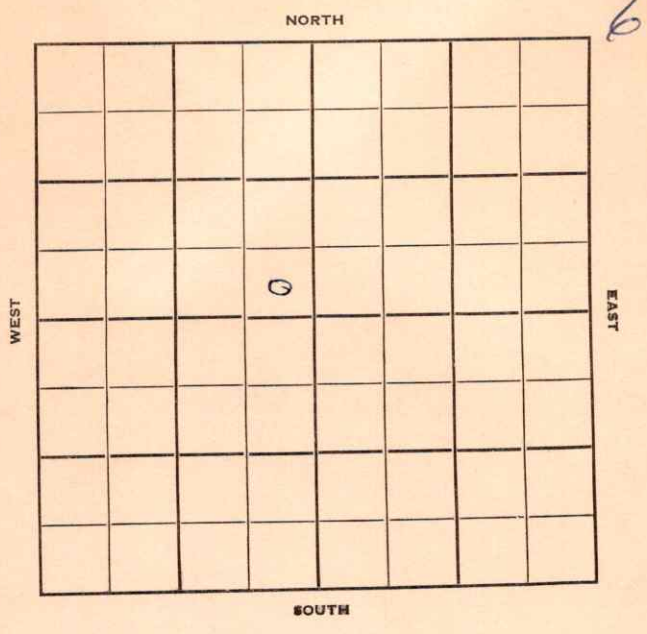

Russell

KANSAS

Sec. 16 Twp. 14 R. 13W

Well No. #1 Chester Bear Farm

Texas Company Company

Wakefield Contractor


Ft. from N. Line

330 Ft. from S. Line

330 Ft. from E. Line

Ft. from W. Line

NW 1/4 SE SE NW

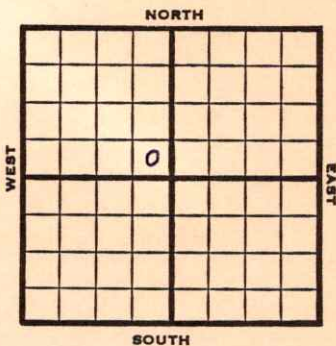

1952 Elev. 1859' REPORT

11/5 RUCT  
 11/12 13" @ 412' Drlg. 710'  
 11/20 10" @ 811 Drlg.  
 11/27 Drlg. 2270'  
 12/4 Tarkio 2385 TD 5410 7" @2410  
 12/11 DD 2423 Wtr SO 2415 PB 245 SO&W  
 PB 2414 SO&W St - frac  
 12/18 Testing  
 12/25 Testing  
 1953  
 1/7 Spud 11-4-52 Oil well TD 2423'  
 13" @ 412 10" @ 811 Tarkio 2385'  
 TD 2410' 7" @ 2410' DD 2423' 15 GWPH  
 SO 2415 PB 2415 4.7 GO 29 GWPH  
 PB 2414 1 GO 2 GWPH st-frac.  
 S/11 BO 3 BWPH 6 hr. S/6 BO 4 BWPH  
 9 hr. PB 2401 14/2385-89 9 GOPH  
 st-frac. S/ 5 1/2 BO 1 BWPH 8 hr.  
 Comp. 45 BOPD 48 BW

COMPLETED



