


Section 19 Township 14 Range 13 W

Well No. # 4 H. Rein

Company El Dorado Ref.

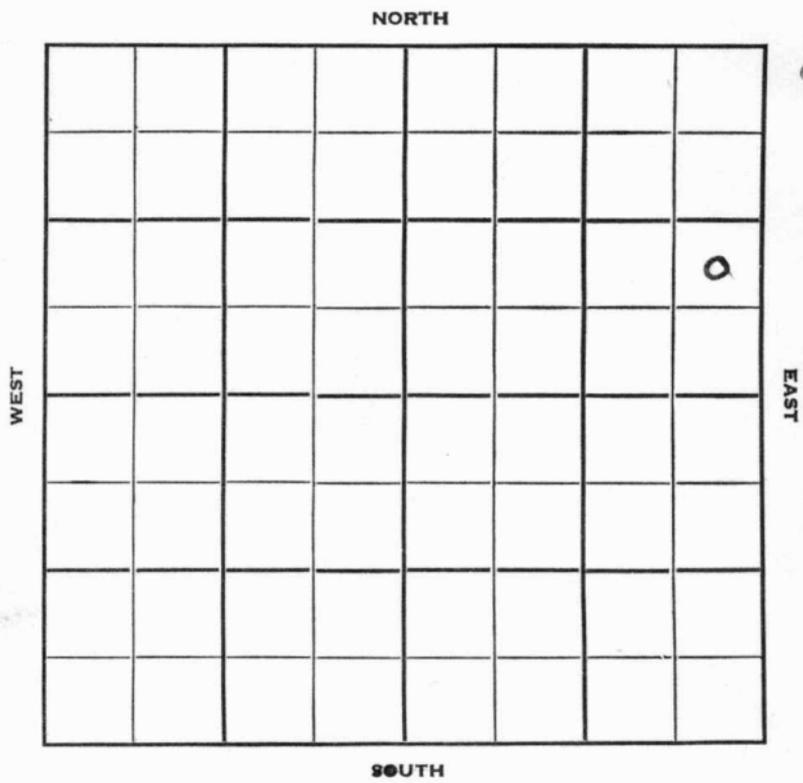

Sec. 19 Twp. 14 R. 13W

Well No. #4 H. Rein Farm

ELDorado Ref. Company

Contractor


Ft. from N. Line

990 Ft. from S. Line

330 Ft. from E. Line

Ft. from W. Line

NE SE NE

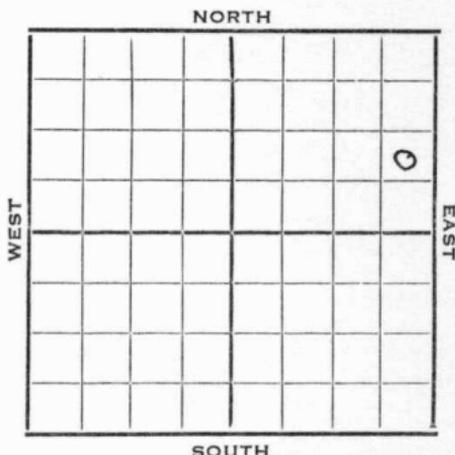

1952 Elev. 1790' REPORT

7/30 Cellar & pits

8/6 RUST

8/13 15" @ 36'

Drlg. 280'

8/21 Drlg. 425'

8/27 13" @ 444

Anhy 753

10" @ 762

Drlg. 1145'

9/3 Drlg. 2222'

9/10 7" @ 2281 1st Tarkio 2319'

2nd Tarkio 2336'

TD 2339' PB 2337' To Hyd

9/17 Spud 8-8-52

Oil Well TD 2339'

15" @ 36 13" @ 444

Anhy 753' 10" @ 762' 7" @ 2281

1st Tarkio 2319 2nd Tarkio 2336

TD 2339 PB 2337 Hydro.

S/ 4 boph Comp. 50 bopd

COMPLETED

County **Russell** State **Kansas**

Sec. **19** (Blk. Twp.) **14** (Sur. Rge.) **13W** Map No.

Operator **Eldorado Ref.**

Well No. **4** Farm **H. Rein**

Elev. Location **NE SE NE**

| | | | | | |
|---------------------|--|--|--|--|---|
| | | | | | |
| | | | | | |
| | | | | | 0 |
| | | | | | |
| FIRST REPORT | | | | | |
| | | | | | |
| | | | | | |

990 Ft. From **S** Line **NE**
330 Ft. From **E** Line Quarter

Ist. Report **JUL 30 1952**

Completion

Remarks

Spudding Date

Drlg. Data

Cellar & pits

