


Section 16 Township 14 Range 13W

Well No. 2 Chester Bear

Company Texas Co.

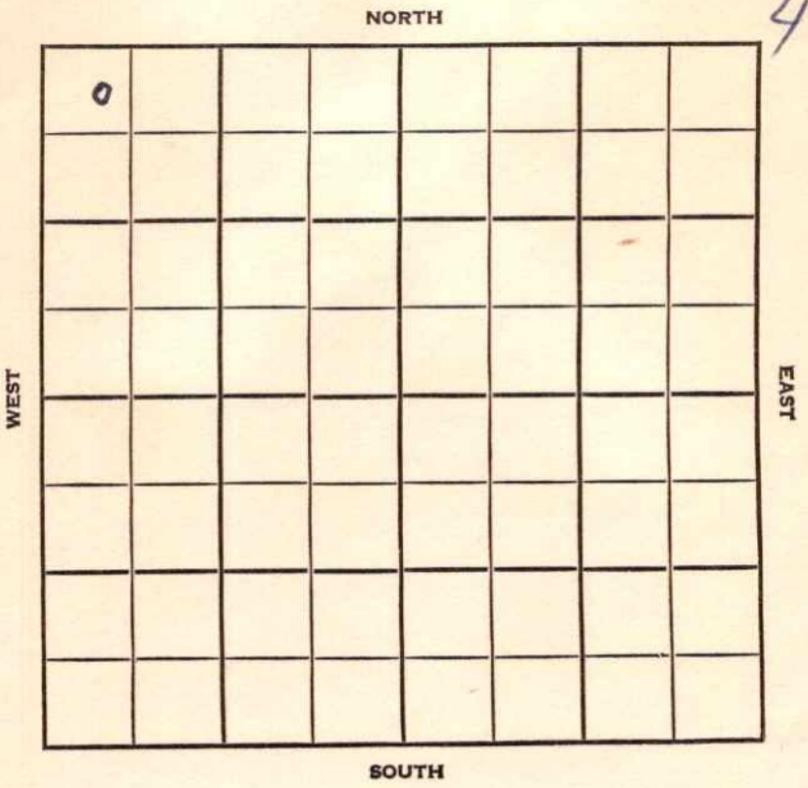

SEC.	TWP.	R.
16	14	13 W

WELL NO.

2 Chester Bear FARM

COMPANY

Texas Company

CONTRACTOR

Wakefield

Hall-Gurney Pool


330 Ft. from N. Line

Ft. from S. Line

Ft. from E. Line

486 Ft. from W. Line

NW NW NW

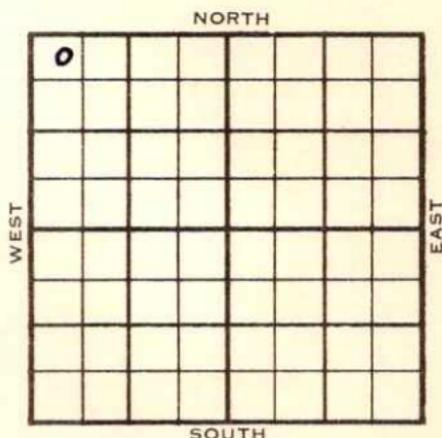

1955	ELEVATION	REPORT
	1871'	

2/2 Location
 3/16 Spud 2-8-55 Oil Well TD 2438
 13 1/2" @ 510 Tarkio 2407
 TD 2438 7" @ 2437 CO to 2416
 18/2408-11
 1 1/2 GWPH 2 hr frac
 Comp 48 BOPD 9 BW

COMPLETED

County Russell State Kansas

Sec. 16 (Blk. 14 (Sur. 13W (Twp. 14 (Rge. 13W Map No.

Operator Texas Company

Well No. 2 Farm Chester Bear

Elev. _____ Location NW NW NW

0					

330 Ft. From N Line NW

486 Ft. From W Line Quarter

1st. Report FEB 2 1955

Completion _____

Remarks _____

Wakefield - Contr.

Spudding Date _____

Drig. Data Hall-Gurney Pool

Location

County Russell State Kansas

Sec. 16 (Blk. 14 (Sur. 13W Map No. 14) (Rge.)

Operator Texas Company

Well No. 2 Farm Chester Bear

Elev. 1871 Location NW NW NW

o					

330Ft. From N Line NW

486Ft. From W Line Quarter

1st. Report

Completion MAR 1 6 1955

Remarks Hall-Gurney Pool

Wakefield - Contr.

Spudding Date 2-8-55

Drig. Data Oilwell TD 2438

13 1/2" @ 510 Tarkio 2407 TD 2438

7" @ 2437 CO to 2416 18/ 2408-11

1 1/2 gwph 2 hr. frac

Comp. 48 bopd 9 bw

FABEN GILSTRAP