


Section 19 Township 14 Range 13-W

Well No. 1 Phinney

Company Cities Service oil

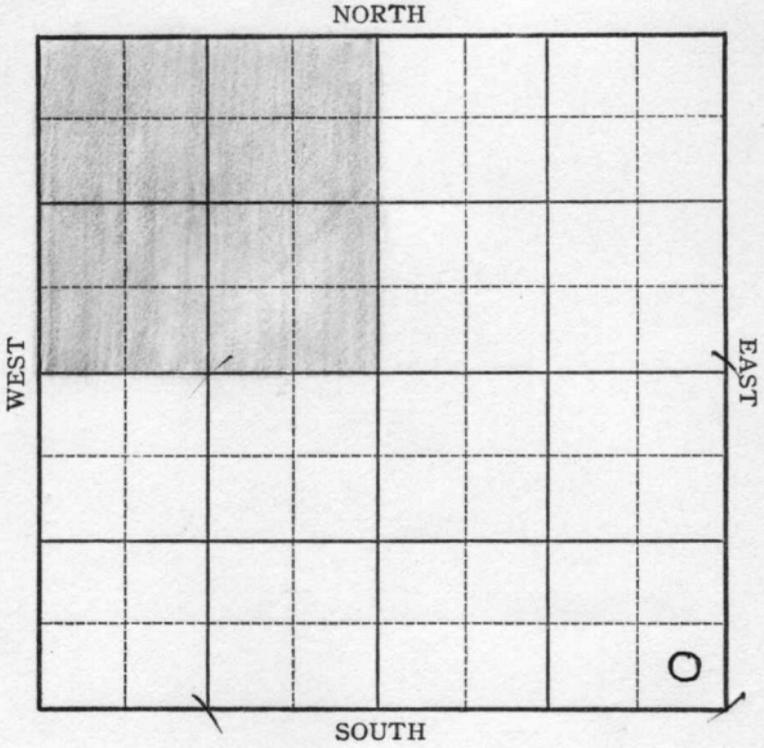

Sec. 19 Twp. 14 R. 13-W

Well No. #1 Phinney Farm  
Cities Service Oil Company


\_\_\_\_\_ Ft. from N. Line

330 Ft. from S. Line

330 Ft. from E. Line

\_\_\_\_\_ Ft. from W. Line

*Special*

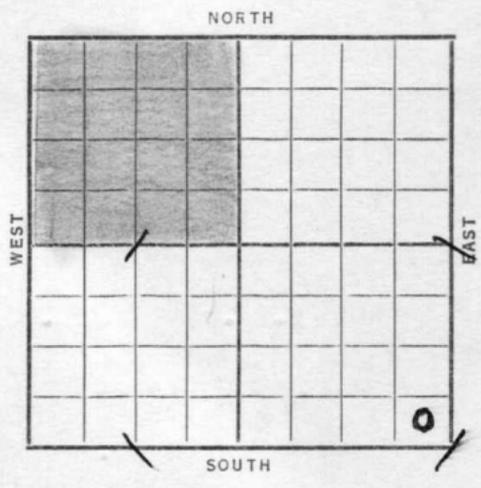

Date	REPORT
1938	
1/5	B.R.R.
1/14	R U R
1/20	Spud
1/28	20" - 49'      15" - 345'
	Anhy 705'      12" - 715'
	Drlg. 880'
2/4	Drlg. 2050'
2/11	S.G. 2265-70'.      10" @ 2338'.
	Drlg. 2625'.
2/18	8" @ 2845'.      K.C. 2892'.
	T.D. 2915'.      U. R. 8".
2/26	8" @ 2915'.      Granite wash 3162'.
	7" @ 3171'.      Pay 3203-06'.
	<del>170' @ 3171' by 2 1/2 hours</del>
3/3	Granite Wash 3162      T.D. 3290
	No show      D & A
	<b>OVER</b>

1938

3/2 7" @ 3177'.

Granite wash 3162'.

T.D. 3290'.

150' water @ 3220-25 in 4 hrs.

No shows.

ABANDONED



Russell KANSAS

Map No. \_\_\_\_\_ Sec. 19 Twp. 14 R. 13W

Well No. 1 Phinney

Cities Service Oil Company

Contractor

ABANDONED

SE/C

\_\_\_\_\_ Ft. from N. Line

330 Ft. from S. Line

330 Ft. from E. Line

\_\_\_\_\_ Ft. from W. Line

SECTION PLAT

			0

Location \_\_\_\_\_

Rig up \_\_\_\_\_

Drilling and Remarks:

*150' water ~~was~~ @  
3220-25 in 4hrs  
No shows*

*DVA*

RECORD

Cased 7 in. 3177 ft.

Sand Granite Wash 3162

Gas \_\_\_\_\_

Oil \_\_\_\_\_

Total Depth 3290

PRODUCTION

1st 24 hrs. Nat. \_\_\_\_\_

1st 24 hrs. after shot \_\_\_\_\_

Gas \_\_\_\_\_ Cu. Ft.

Dry Hole \_\_\_\_\_

Abandoned \_\_\_\_\_

Date

MAR 2 - 1938 19

H. D. Hatfield Scout