


Section 15 Township 14 Range 13 W

Well No. # 6 Hoke

Company Duke & Wood

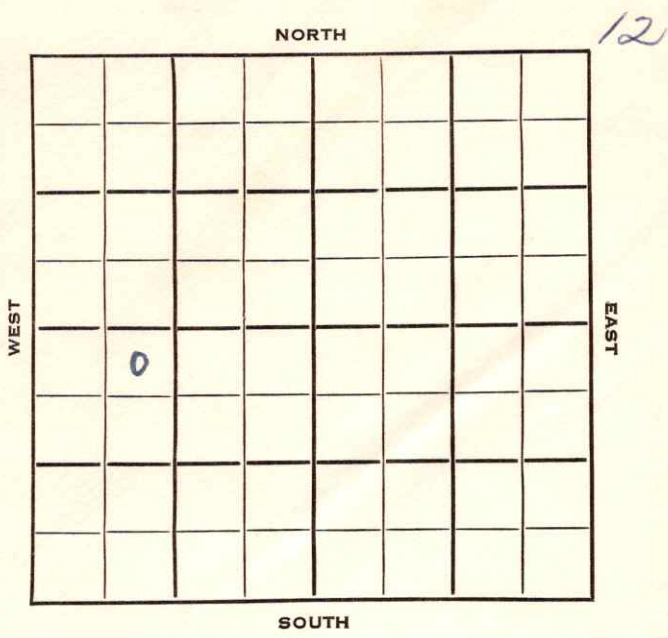

Russell

KANSAS

SEC.	15	TWP.	14	R.	13W
------	----	------	----	----	-----

WELL NO.

#6 Hoke

FARM

COMPANY

Duke &amp; Wood

CONTRACTOR

Duke &amp; Wood

Hall-Gurney Pool

330

Ft. from N. Line


Ft. from S. Line

Ft. from E. Line

990

Ft. from W. Line

NORTH

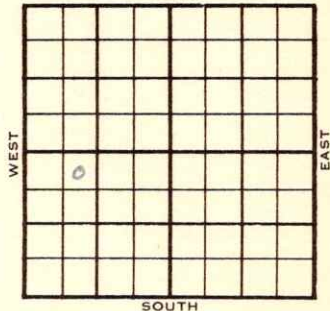

NE NW SW

SOUTH

1953

ELEVATION

1775'

REPORT

10/14

Spud 10-9-53

8" @ 232'

Anhy 726'

Drlg 1590'

10/21

Tarkio 2306'

RTD 2340

5" @ 2340

10/28

NR

11/4

36/2308-11 1 1/4 BOPH sd-frac.

11/11

Spud 10-9-53

Oil Well

TD 2340'

8" @ 232'

Anhy 726', Tarkio 2306',

TD 2340'

5" @ 2340'

36/ 2308-11 1 1/4 boph sd-frac 2 1/2 boph

Comp. 25 bopd.

COMPLETED



