


Section 15 Township 14 Range 13W

Well No. 7 Hoke

Company Duke & Wood

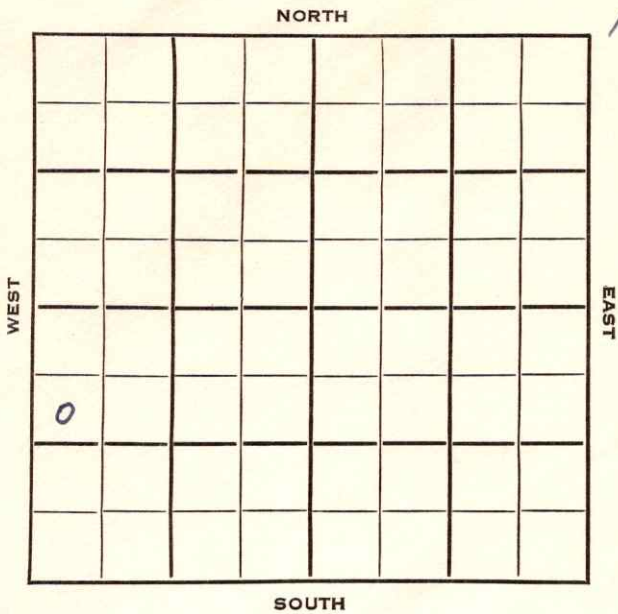

KANSAS

SEC.	TWP.	R.
15	14	13 W

WELL NO.

7 Hoke

FARM

COMPANY

Duke & Wood

CONTRACTOR

Duke & Wood

Hall-Gurney Pool


990 Ft. from N. Line

Ft. from S. Line

Ft. from E. Line

330 Ft. from W. Line

SW NW SW

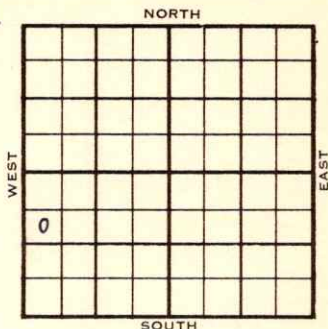

1954	ELEVATION 1790'	REPORT
------	--------------------	--------

2/24 Spud 2-21-54
8" @ 244 WOC

3/3 Tarkio 2326 RTD 2360 5" @ 2359

3/10 CO 2340 60/2326-30 18 GO + 2 GWPH
12 hrs. Sd-on¹frac.

3/17	NR
------	----

3/24	Spud 2-21-54
------	--------------

Oil Well

 td 2360' |

8" @ 244'

Tarkio 2 326'

TD 2360

5" @ 2359'

CO to 2340

60/2326-30

18 go 2 gwph 12 hrs.

Sd-oil-frac

S/2½ boph 4 hrs.

Comp. 25 bopd

COMPLETED

County Russell State Kansas

Sec. 15 (Blk. Twp.) 14 (Sur. Rge.) 13W Map No.

Operator **Duke & Wood**

Well No. **7** Farm **Hoke**

[illegible]

FIRST REPORT

990 Ft. From N Line SW

330 Ft. From W Line Quarter

1st. Report

Completion

Remarks

Duke & Wood - Contr.

Spudding Date 2-21-54

Drbg. Data Hall-Gurney Pool

8" 244 WOC

J. G. McGEHEE

County Russell State KansasSec. 15 (Blk.) 14 (Sur.) 13 W Map No.Operator Duke & WoodWell No. 7 Farm HokeElev. 1790 Location SW NW SW990 Ft. From N Line SW330 Ft. From W Line Quarter1st. ReportCompletion MAR 24 1954Remarks Hall-Gurney PoolDuke & Wood - Contr.Spudding Date 2-21-54Drig. Data Oil well TD 23608" @ 244 Tarkio 2326 TD 23605" @ 2359 CO to 2340 60/ 2326-3018 go 2 gwph 12 hr. sd-okl-fracS/ 2 1/2 boph 4 hr. Comp. 25 bopd