


Section 19 Township 14- Range 13-W

Well No. #7 Ehrlick

Company N C R A

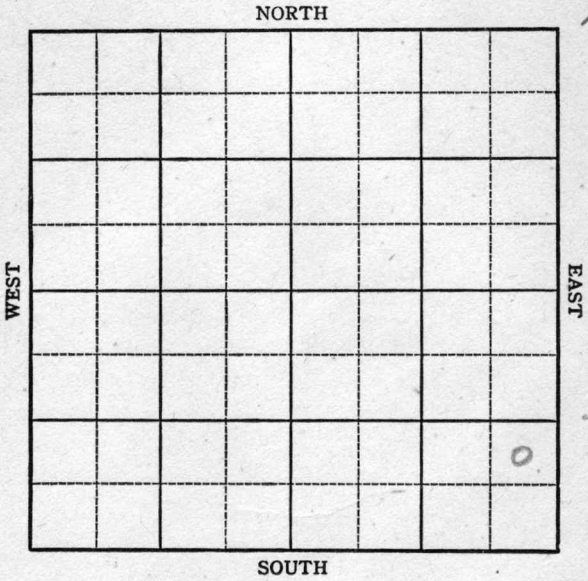




Sec. 19 Twp. 14 R. 13-W

Well No. #7 Ehrlick Farm  
N C R A Company  
Hall-Gurney Pool

Ft. from N. Line  
990 Ft. from S. Line  
330 Ft. from E. Line  
Ft. from W. Line

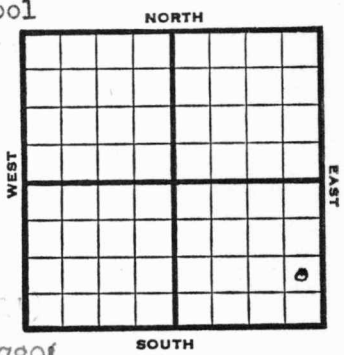

NE SE SE Elev. 1780'

REPORT

1947

- 3/12 Location
- 3/18 Anhy 728'  
7" @ 740'  
WOC
- 3/25 Topeka 2645'  
Drlg 2881'
- 4/2 Lansing 2917'  
Granite wash 3185  
5" @ 3184'  
Drlg. 3211' in Granite wash.
- 4/9 TD 3235'  
24 shots 2941-58 3000 Acid  
Swb 10 bbls oil PH
- 4/16 Lans 2917  
Granite wash 3183  
Perf Lans  
5" @ 3184  
3000 Acid  
Pump 106' oil & 10% W Pot.  
Grav. 40.9  
TD 3234'

COMPLETED

Map No. 72 Sec. 19 Twp. 14 R. 13W

Well No. 7 Ehrlick

N C R A Company

**FIRST REPORT**

Contractor

NE SE SE

**SECTION PLAT**

			6

\_\_\_\_\_ Ft. from N. Line

990 Ft. from S. Line

330 Ft. from E. Line

\_\_\_\_\_ Ft. from W. Line

Russell County

Location X

Rig up \_\_\_\_\_

Drilling and Remarks:

**RECORD**

Cased \_\_\_\_\_ in., \_\_\_\_\_ ft.

Sand \_\_\_\_\_

Gas \_\_\_\_\_

Oil \_\_\_\_\_

Total Depth \_\_\_\_\_

**PRODUCTION**

1st 24 hrs. Nat. \_\_\_\_\_

1st 24 hrs. after shot \_\_\_\_\_

Gas \_\_\_\_\_ Cu. Ft.

Dry Hole \_\_\_\_\_

Abandoned \_\_\_\_\_

Date

MAR 12 1947 19

S. J. LEWIS Scout

