

Barton


KANSAS

FORM 51 5M PETROL

Section 12 Township 16 Range 14-W

Well No. #4 Sausen

Company Earl Wakefield

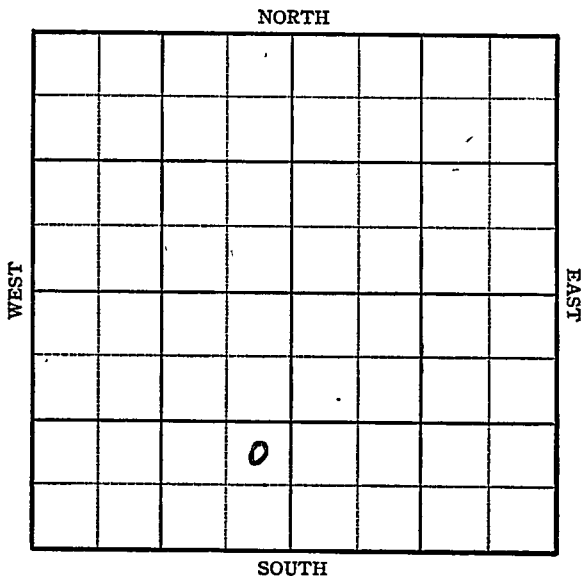

KANSAS

Barton

Sec. 12 Twp. 16 R. 14³⁴

Well No. #4 Sausen Farm


Earl Wakefield Company

330 Ft. from N. Line

990 Ft. from S. Line

330 Ft. from E. Line

_____ Ft. from W. Line

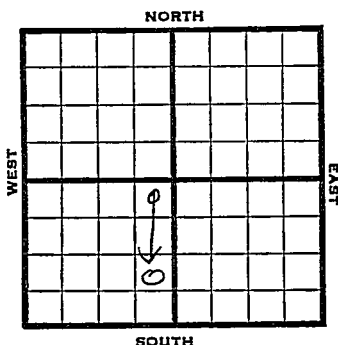

NE ~~SW~~ SE SW

1945 Elev. 1916 REPORT

12/12 RUR

12/20 8" - 615' Anhy 882' Drlg. 1980'

12/29 Drlg. 2310'

1946

1/10 SD 2310'

1/17 5" - 3384' T.D. 3384'

1/23
Lans 3120
Arb. 3347
5" @ 3348
TD 3384'

ABANDONED

KANSAS Kansas Pool Name TrappMap No. K-73 Sec. 12 Twp. 16 R. 14WWell No. 4 SausenEarl Wakefield CompanyFIRST REPORT Contractor

NE SW

SECTION PLAT

	o		

330 Ft. from N. Line Ft. from S. Line330 Ft. from E. Line Ft. from W. LineBarton Cou tyLocation Rig up

Drilling and Remarks:

RUR

RECORD

Cased in., ft.Sand Gas Oil Total Depth

PRODUCTION

1st 24 hrs. Nat. 1st 24 hrs. after shot Gas Cu. Ft.Dry Hole Abandoned

Date

DEC 12 1945 19S. J. LEWIS Scout

Kansas Pool Name Trapp

Map No. 7-73 Sec. 12 Twp. 16 R. 14W

Well No. 4 Sausen

Earl Wakefield Company

CORRECTION Contractor

NE SE SW

SECTION PLAT

 Ft. from N. Line

990 Ft. from S. Line

330 Ft. from E. Line

 Ft. from W. Line

Barton

Location

Rig up

Drilling and Remarks:
Reported NE SW

RECORD

Cased in., ft.

Sand

Gas

Oil

Total Depth

PRODUCTION

1st 24 hrs. Nat.

1st 24 hrs. after shot

Gas Cu. Ft.

Dry Hole

Abandoned

Date

DEC 19 1945

S. J. LEWIS Scout

KANSASKansas Pool Name TrappMap No. 73 Sec. 12 Twp. 16 R. 14WWell No. 4 SausenEarl Wakefield

Company

ABANDONED

Contractor

NE SE SW

E 11/19/16
SECTION PLAT

	0		

 Ft. from N. Line990 Ft. from S. Line330 Ft. from E. Line Ft. from W. LineBarton CountyLocation Rig up

Drilling and Remarks:

lane 3120CR 33475" @ 3348

RECORD

Cased in., ft.Sand Gas Oil Total Depth 3384

PRODUCTION

1st 24 hrs. Nat. 1st 24 hrs. after shot Gas Cu. Ft.Dry Hole Abandoned

Date

JAN 23 1946 19S. J. LEWIS

Scout