


DX 78-1 Russell

KANSAS

Section 15 Township 14 Range 13W

Well No. #1 Hoke "B"

Company Murfin Drlg.

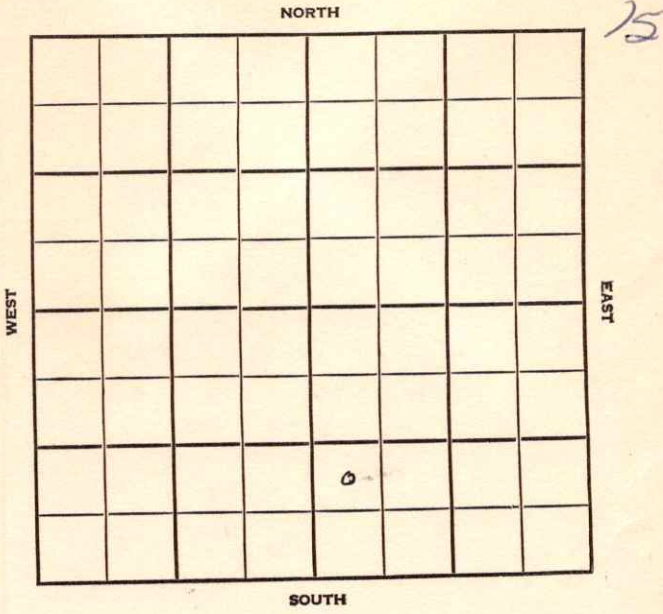

SEC.	TWP.	R.
15	14	13W

WELL NO. #1 Hoke "B" FARM

COMPANY Murfin Drlg.

CONTRACTOR Co. Tools.

Hall-Gurney Pool

Ft. from N. Line


990

Ft. from S. Line

Ft. from E. Line

330

Ft. from W. Line

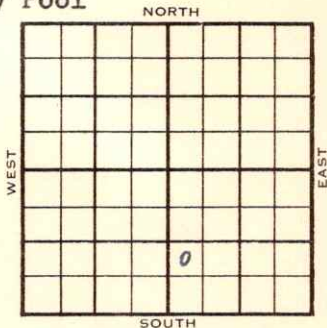

NW SW SE

1954	ELEVATION	REPORT
	1811'	

11/17 Spud 11-15-54

12/8 Spud 11-15-54

Anhy 760', 1st Tarkio 2347', 2nd Tarkio 2358'

TD 2371'

D & A

ABANDONED



