


DX 78-1 Russell

KANSAS

Section 16 Township 14 Range 13W

Well No. 3 C. Dumler

Company Lewis Mai

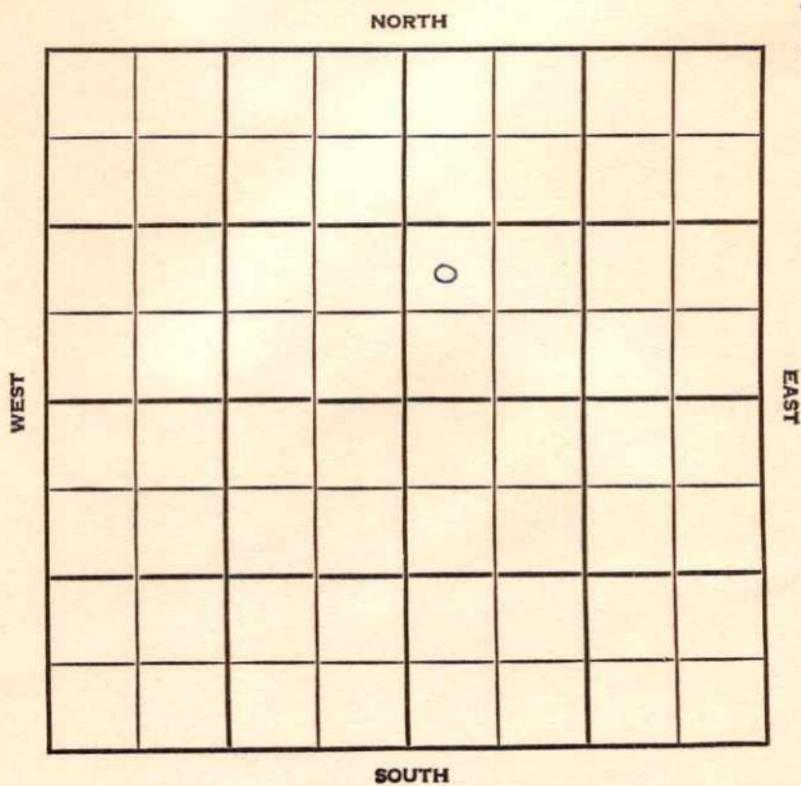

SEC.	TWP.	R.
16	14	13 W

WELL NO. # 3 C. Dumler FARM

COMPANY Lewis Mai

CONTRACTOR Co. tools

Hall-Gurney Pool


_____ Ft. from N. Line

990 _____ Ft. from S. Line

_____ Ft. from E. Line

330 _____ Ft. from W. Line

NW SW NE

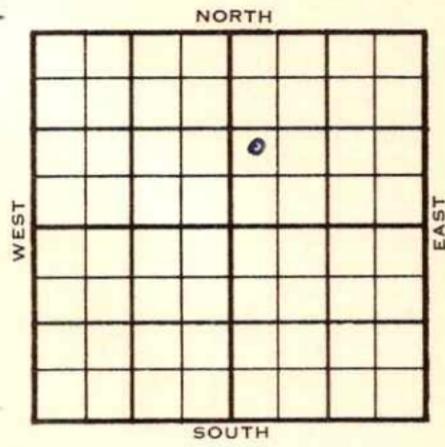

1955	ELEVATION 1861'	REPORT
------	--------------------	--------

4/27 RUCT
 5/26 2nd Tarkio 2403'
 TD 2406 7" @ 2403 sd-oil-frac
 S/wtr. D & A.

ABANDONED

ABANDONED

County Russell Elev. 1861

Sec. 16 Twp. 14 Rge. 13W


Company Louis Mai

Farm Name C. Dumler No. 3

TOPS	DEPTH	DATUM
Cim. Anhydrite		
Ft. Riley		
Howard		
Topeka		
Heebner Sh.		
Toronto Ls.		
Brown Lime		
Lansing		
Kans. City		
B. K. C.		
Congl.		
Miss. <u>2nd Tarkio</u>	<u>2403</u>	
Kinderhook		
Misener		
Hunton		
Sylv. Maquo		
Viola		
Simpson		
Smp.		
Gorham		
Arbuckle		
Basal Sand		
Pre. Cam.		
T. D.		

Loc. in Section
NW SW NE

Drlg. Contr.
Pool Hall-Gurney

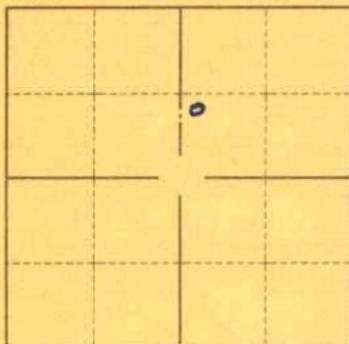

Date Comm.
Date Comp. MAY 25 '55

2nd Tarkio 2403 TD 2406 7" @ 2403
sd-oil-frac S/wtr.
D & A

Co.

Lse.

No.

S.

T.

R.