


Section 16 Township 14 Range 13W

Well No. #1 Dumler

Company Lee Phillips

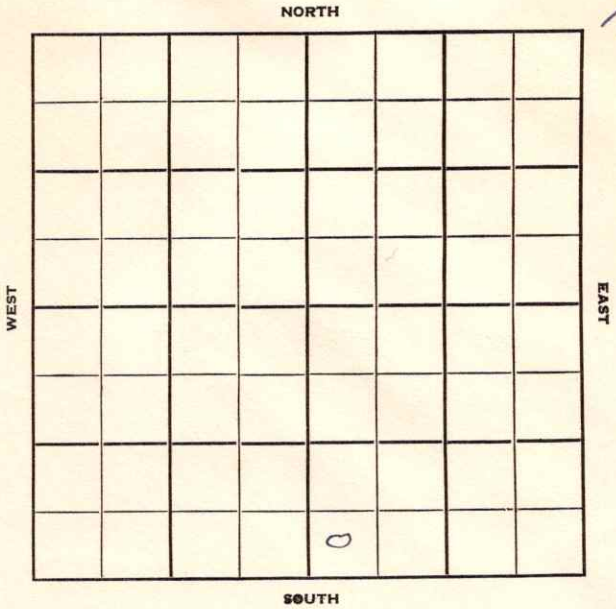

Sec. 16 Twp. 14 R. 13W

Well No. #1 Dumler Farm

Lee Phillips Company

Contractor


Ft. from N. Line

330 Ft. from S. Line

Ft. from E. Line

330 Ft. from W. Line

SW SW SE

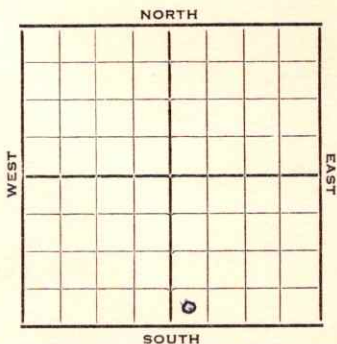

1952 **Elev. 1872'** REPORT

4/9 Location

4/23 RUR

4/30 10" @ 530 Drlg. 533'

5/7 **Anhy 821'**

8" @ 817'

Drlg. 1830'

5/14 **Tarkio 2402-07' RTD**

5/21 DD 2409 TD 7" @ 2402 CO 2409  
S/6 Galoph Strato-frac S/2 Boph  
tub & rods

5/28 NR

6/11 "

6/18 Spud 4-25-52

Oil Well TD 2407' 10" @ 530'

**Anhy 812** 8" @ 817' **Tar. 2402**

TD 2409 7" @ 2402' S/ 6 goph

Stratofrac S/ 2 boph

Comp. 30 bopd

**COMPLETED**



