


Section 10 Township 13 Range 19 W

Well No. # 1 Mermis

Company Davis Bros & Transit Drlg.

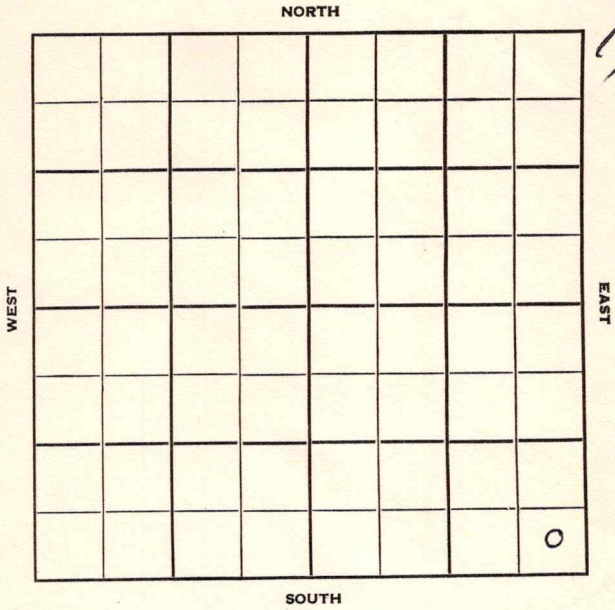

Ellis

KANSAS

Sec. 10 Twp. 13 R. 19 W

Well No. # 1 Mermis Farm

Davis Bros. & Transit Drlg. Company

Transit Drlg. Contractor


Wildcat

_____ Ft. from N. Line

330 Ft. from S. Line

330 Ft. from E. Line

_____ Ft. from W. Line

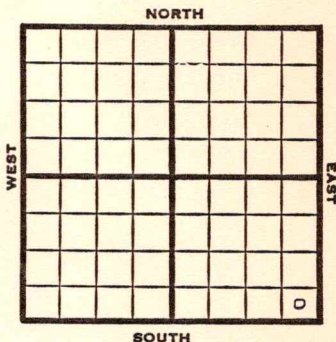

SE SE SE
Atlantic DHM

1951 **Elev. 2100'** REPORT

5/2 Spud 4-30-51
Drilling

5/16 Spud 4-30-51
 D & A TD 3780'
 8" @ 184 Anhy 1385' Heeb 3365'
 Tor. 3388' Lans. 3415'
 DST 3488-3504' open 1 hr. rec 235' SW
 Arb. 3769' TD 3780' D & A

ABANDONED

