

Sec. 16 Twp. 14 R. 13W

Well No. #2 Dumler Farm

Lee Phillips Company

Gall Gurney Contractor

Ft. from N. Line

330


Ft. from S. Line

Ft. from E. Line

990

Ft. from W. Line

SE SW SE

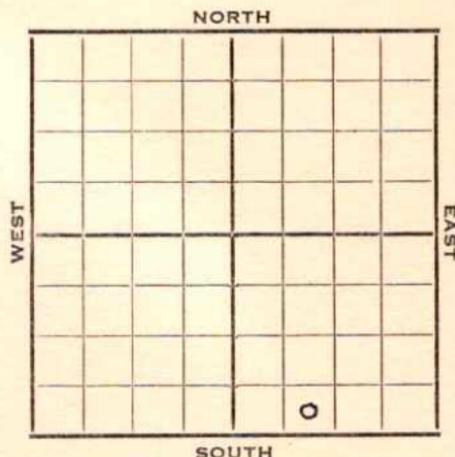

1952

Elev. 1865' REPORT

6/25

Spud 6-21-52
Drlg. 400'

7/2

10" @ 510 8" @ 808
Anhy 803 Drlg. 1490'

7/9

Drlg. 2300'

7/16

Spud 6-21-52
Oil well TD 2397' 10" @ 510'
8" @ 808 **Anhy 803'** **Tarkio 2390'**
7" @ 2390 TD 2397 B/11 GOPH
B-Hydro. S/3½ BOPH
Comp. 30 BOPD

COMPLETED

