


Section 11 Township 15 Range 14W

Well No. 5 Flegler "C"

Company N. C. R. A.

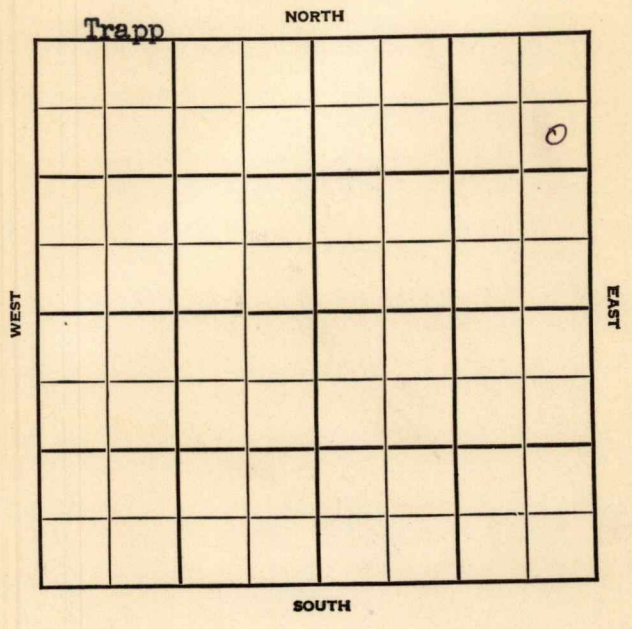

Sec. 11 Twp. 15 R. 14W

Well No. #5 Flegler "C" Farm _____

N C R A

Company _____

Trapp Pool


990' Ft. from N. Line

_____ Ft. from S. Line

330' Ft. from E. Line

_____ Ft. from W. Line

SE NE NE

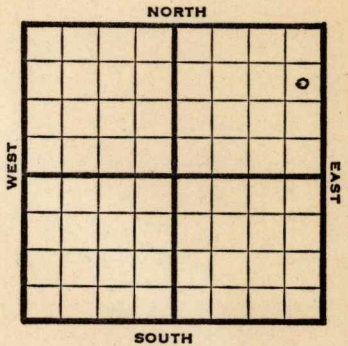

1948

Elev. 1855'

REPORT

3/3	Location
3/10	"
3/17	"
3/24	"
3/31	10" @ 845' WOC
4/7	Drlg. 1610'
4/14	Drlg. 2395'
4/21	Tarkio 2416' SO 2416-25 8 1/2" @ 2531' SO 2610-25 Drlg. 2775'
4/28	Lansing 3041' KC 3063' Drlg. 3152'
5/5	7" @ 3107' Arbuckle 3300' TD 3305' Run 5"
5/12	"
5/19	5" @ 3301' 2900' oil 18 hrs.
5/26	"
6/1	"

OVER

1948

6/9 5"@ 3301'
2900' oil 18 hrs.

6/16 TD 3305'
Arb. 3300'
7"@ 3107'
5"@ 3301'
Pump 111 Oil Pot
40⁹ Gr.
Comp.

COMPLETED

O. W. P. B.

1954
8/25

Oil Well
TD 3305'
Dodge 2991', KC 3063', Arb. 3300'
5" @ 3301'
OTD 3305'
PB 3257'
36/3222-30, 1000A
S/1 bo 14 bwph 14 hs.
PB 3170
16/3134-48, 32/3112-20, 1000A
S/7 bopd 40/3076-86, 2000A
S/4 bfph 14 hrs., 66% wtr.
42/2991-98, 5000A
Comp. 25 BOPD 3 bw

FIRST REPORT

COMPLETED

Map No. _____ Sec. 11 Twp. 15 R. 14W

Well No. 5 Flegler "C"

N C R A

Company

FIRST REPORT

Contractor

SE NE NE

SECTION PLAT

990 Ft. from N. Line

_____ Ft. from S. Line

330 Ft. from E. Line

_____ Ft. from W. Line

			△

Russell County

Location X

Rig up _____

Drilling and Remarks:

RECORD

Cased _____ in., _____ ft.

Sand _____

Gas _____

Oil _____

Total Depth _____

PRODUCTION

1st 24 hrs. Nat. _____

1st 24 hrs. after shot _____

Gas _____ Cu. Ft.

Dry Hole _____

Abandoned _____

Date

MAR 3 1948

19

S. J. LEWIS

Scout

Map No. 73 Sec. 11 Twp. 15 R. 14W

Well No. 5 Flegler "C"

N C R A

Company

COMPLETE

Contractor

SE NE NE

E. 1805
SECTION PLAT

990 Ft. from N. Line

_____ Ft. from S. Line

330 Ft. from E. Line

_____ Ft. from W. Line

Russell County

Location _____

Rig up _____

Drilling and Remarks:

at 3300
7" @ 3107
5" @ 3301
Pump 111 oil 28
40 3/4

RECORD

Cased _____ in., _____ ft.

Sand _____

Gas _____

Oil _____

Total Depth 3305

PRODUCTION

1st 24 hrs. Nat. _____

1st 24 hrs. after shot _____

Gas _____ Cu. Ft.

Dry Hole _____

Abandoned _____

Date

JUN 16 1948 19

S. J. LEWIS Scout

