


Section 19 Township 14 Range 13W

Well No. 1 Rein

Company Advanced Drilg. GLEASON DRIG.

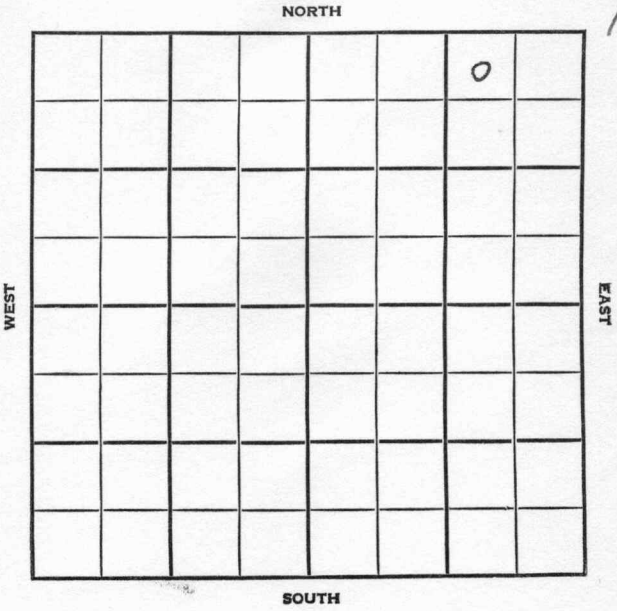

correct ✓

County Russell Elev. 1796
 Sec. 19 Twp. 14 Rge. 13W
 Company Gleason Drlg. (Was Advance)
 Farm Name Rein No. 1

TOPS	DEPTH	LOG	DATUM	Loc. in Sec.				
Anh.	759			NW NE NE				
Tp. <u>Tarkio</u>	2318		522					
H.	2873		1077					
Tr. <u>Dodge</u>	2888		1092					
Dg.								
Bl.								
L.								
K.C.	2948		1152	Geol.				
B.K.C.				Contr.				
Ce.								
C.	3221		1425					
M.								
M.				Pool				
K.				Hal 1-Gurney				
Mz.								
Mq.								
V.								
S.								
S.								
A	3248		1452	<table border="1"> <tr> <td>X</td> <td>o</td> </tr> <tr> <td colspan="2" style="text-align: center;">COMPLETE</td> </tr> </table>	X	o	COMPLETE	
X	o							
COMPLETE								
R.								
Pe.								
G.								
T.D.	3252							

Date Comm. 4-10-55 JUN 15 1955
 12" @ 410 10" @ 759 8 5/8" @ 2376
 7" @ 2916 5 1/2" @ 3249 CO to 2349
 24/ 2318-24 B/ 4 go 1/2 bw frac
 S/ 8 boph 10% wtr. SP 2338 24/ 2318-
 24 500 A 4 go 1/2 bw frac S/ 8 boph
 10% wtr. Comp. 25 bopd 10% wtr.