


FORM 51 25M 3-49 PETROL

Section 19 Township 14 Range 13W

Well No. #2 Rein

Company Lindas Oil

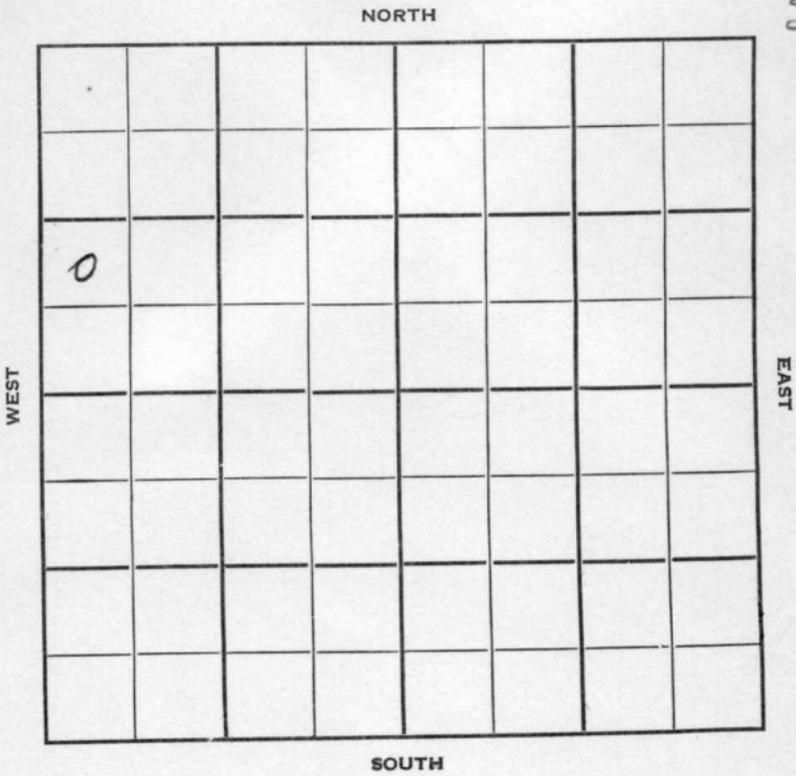

Sec. 19 Twp. 14 R. 13W

Well No. ~~#1~~ #2 Rein \_\_\_\_\_ Farm \_\_\_\_\_

Lindas Oil \_\_\_\_\_ Company  
Hall Gurney (Russell Drlg. Contr.)


\_\_\_\_\_ Ft. from N. Line

990' Ft. from S. Line

\_\_\_\_\_ Ft. from E. Line

330' Ft. from W. Line

NW SW NW

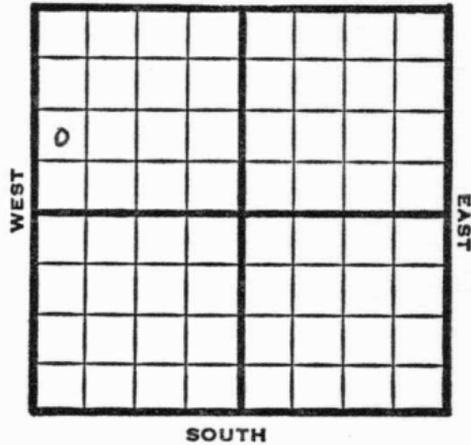

1949

Elev 1785' REPORT

12/28

Machine

1950  
2/22

TD 2355'  
10"@ 430'  
5"@ 2328'  
Anhy 745'  
TD 2340'  
21 BOPD  
Comp

**COMPLETED**

Map No. \_\_\_\_\_ Sec. 19 Twp. 14 R. 13W

Well No. 2 Rein

Lindas Oil

Company

Russell Drlg.

Contractor

NW SW NW

**FIRST REPORT  
SECTION PLAT**

\_\_\_\_\_ Ft. from N. Line

990 Ft. from S. Line

\_\_\_\_\_ Ft. from E. Line

330 Ft. from W. Line

0			

Russell County

Location \_\_\_\_\_

Rig up \_\_\_\_\_

Drilling and Remarks:

Machine

**RECORD**

Cased \_\_\_\_\_ in., \_\_\_\_\_ ft.

Sand \_\_\_\_\_

Gas \_\_\_\_\_

Oil \_\_\_\_\_

Total Depth \_\_\_\_\_

**PRODUCTION**

1st 24 hrs. Nat. \_\_\_\_\_

1st 24 hrs. after shot \_\_\_\_\_

Gas \_\_\_\_\_ Cu. Ft.

Dry Hole \_\_\_\_\_

Abandoned \_\_\_\_\_

Date

DEC 28 1949 19

S. J. LEWIS

Scout

Kansas

Map No. \_\_\_\_\_ Sec. 19 Twp. 14 R. 13W

Well No. ~~6~~ Rein

Lindas Oil \_\_\_\_\_ Company

Contractor

NW SW NW

EI. 1785  
SECTION PLAT

*Correction  
See back  
Ticket #3 correct*

\_\_\_\_\_ Ft. from N. Line

990 Ft. from S. Line

\_\_\_\_\_ Ft. from E. Line

330 Ft. from W. Line

o			
<b>COMPLETE</b>			

Russell County

Location \_\_\_\_\_

Rig up \_\_\_\_\_

Drilling and Remarks:

10" @ 430  
5" @ 2328  
any 745  
T.D. 2340  
21BOPD  
d

**RECORD**

Cased \_\_\_\_\_ in., \_\_\_\_\_ ft.

Sand \_\_\_\_\_

Gas \_\_\_\_\_

Oil \_\_\_\_\_

Total Depth 2355

**PRODUCTION**

1st 24 hrs. Nat. \_\_\_\_\_

1st 24 hrs. after shot \_\_\_\_\_

Gas \_\_\_\_\_ Cu. Ft.

Dry Hole \_\_\_\_\_

Abandoned \_\_\_\_\_

Date

FEB 22 1950

J. E. TYRA

19

Scout

Your 1st report show #2


Advise

Sam

*Handwritten note:* 1st report show #2

This is correct.

First report incorrect

 

\_\_\_\_\_ Ft. from N. line  
\_\_\_\_\_ Ft. from S. line  
\_\_\_\_\_ Ft. from E. line  
\_\_\_\_\_ Ft. from W. line

RECORD

MAR 7 1950

- Scout Cards *ditto*
- Land Small Map \_\_\_\_\_
- Land Wall Map \_\_\_\_\_
- Tracings \_\_\_\_\_
- France Map \_\_\_\_\_
- Pierce Map \_\_\_\_\_
- Misc. \_\_\_\_\_