

Section 16 Township 14 Range 13W

Well No. 3 - Dumler

Company Lewis Mai

NORTH

13

WEST

EAST

	0						

SOUTH

Sec. 16 Twp. 14 R. 13W

Well No. #3 Dumler Farm _____

Lewis Mai Company _____

Contractor _____

_____ Ft. from N. Line

330

_____ Ft. from S. Line

330


_____ Ft. from E. Line

990

_____ Ft. from W. Line

990

~~SE~~ ~~SW~~ ~~SW~~ ~~SE~~

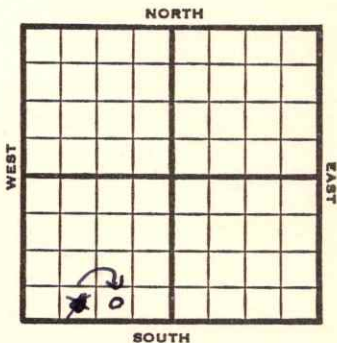

1953

Elev. -

REPORT

1/21

Spud 1-1-53
 12" @ 300
 Anhy 800
 10" @ 800
 1st Tarkio 2388
 2nd Tarkio 2406
 1/2 boph
 TD 2410
 5" @ 2406

1/29
 2/4

NR
 Spud 1-1-53 Oil well TD 2410
 12" @ 300 Anhy 800 10" @ 800
 1st Tarkio 2388' 2nd Tarkio 2406
 1/2 BOPH TD 2410' 5" @ 2406
 CO to 2410 Hydro S/12 BOPH
 P/70 BO 14 hr.
 Comp. 50 BOPD

COMPLETED

Map No. _____ Sec. 16 Twp. 14 R. 13W

Well No. 3 Dumler

Lewis Mai Company

CORRECTION

Contractor

SW SE SW

SECTION PLAT

_____ Ft. from N. Line

330 Ft. from S. Line

990 Ft. from E. Line

_____ Ft. from W. Line

Russell County

Location _____

Rig up _____

Drilling and Remarks:

Reported

SE SW SW

RECORD

Cased _____ in., _____ ft.

Sand _____

Gas _____

Oil _____

Total Depth _____

PRODUCTION

1st 24 hrs. Nat. _____

1st 24 hrs. after shot _____

Gas _____ Cu. Ft.

Dry Hole _____

Abandoned _____

Date

FEB 4 1953 19

J. G. McGEHEE

Scout