


Section 11 Township 15 Range 14 W

Well No. # 10 Flegler "C"

Company N C R A

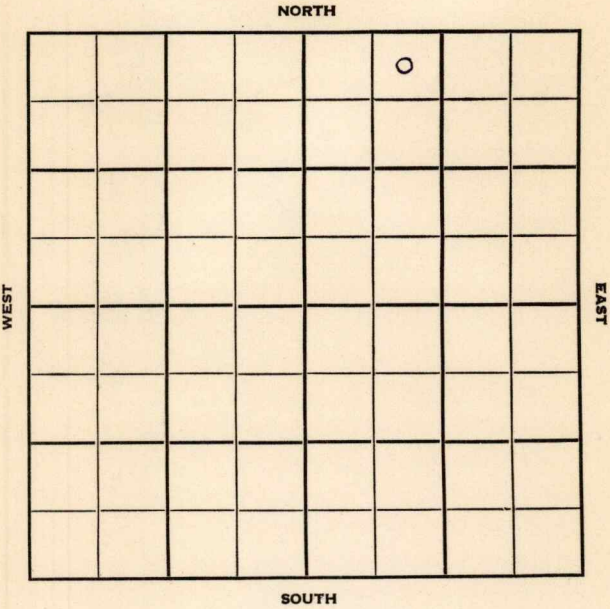

Russell

KANSAS

Sec. 11 Twp. 15 R. 14 W

Well No. # 10 Flegler "C" Farm

N C R A

Company

Murfin Drlg.

Contractor

Trapp Pool


330 Ft. from N. Line

Ft. from S. Line

Ft. from E. Line

990 Ft. from W. Line

NE NW NE

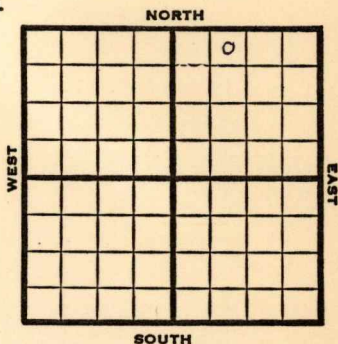

1951

Elev. 1830'

REPORT

5/2

R U R

7/3

Spud 5-3-51 Oil well TD 2404'
13" @ 455 10" @ 825 8" @ 2345'
Tarkio 2399' B/21 GOPH 7" @ 2399'
TD 2404' S/61 BO 1 hr.
Comp. 50 BOPD

COMPLETED

County Russell State Kansas
 Sec. 11 (Blk.) 15 (Sur.) 14W Map No.

Operator N C R A

Well No. 10 Farm Flegler "C"

Elev. Location NE NW NE

FIRST REPORT

330 Ft. From N Line NE

990 Ft. From W Line Quarter

1st. Report MAY 2 1951

Completion

Remarks

Murfin Drlg. - Contr.

Spudding Date

Drlg. Data

Trapp Pool

R U R

J. E. TYRA

County Russell State Kansas
 Sec. 11 (Blk.) 15 (Sur.) 14W Map No.

Operator N C R A

Well No. 10 Farm Flegler "C"

Elev. 1830 Location NE NW NE

COMPLETE

330 Ft. From N Line NE

990 Ft. From W Line Quarter

1st. Report

Completion JUL 3 1951

Remarks Trapp Pool
Murfin Drlg. - Contr.

Spudding Date 5-3-51

Drlg. Data Oil well TD 2404

13" @ 455 10" @ 825 8" @ 2345

Tarkio 2399 B/ 21 goph 7" @ 2399

TD 2404 S/ 61 bo 1 hr. Comp. 50 bopd

J. E. TYRA