

Section 11 Township 15 Range 14W

Well No. #12 Flegler "C"

Company N C R A

NORTH

						0	

WEST

EAST

SOUTH

Russell

Sec. 11 Twp. 15 R. 14W

Well No. #12 Flegler "C" Farm

N C R A

Company

Contractor

Trapp Pool


330' Ft. from N. Line

Ft. from S. Line

990' Ft. from E. Line

Ft. from W. Line

NW NE NE

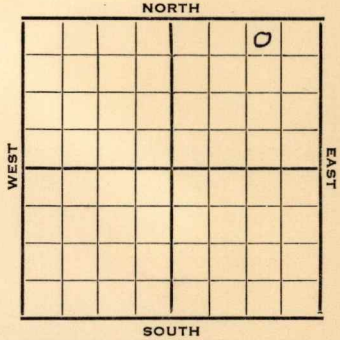

1952 Elev. 1865' REPORT

5/14 Drlg. 35 Spud 5-12-52
 5/21 12" @ 487 Anhy 855'
 10" @ 860' Drlg. 955'
 5/28 Drlg. 1945'
 6/11 Tarkio 2343' 7" @ 2435' DP 2436'
 TD 2439' B/38 gal OPH PB 2437'
 Fill up 190' oil 9 hrs. D - Hyd
 6/18 Fill up 850' oil 13 hrs. S/40 BO &
 trace 12 hrs. POP
 6/25 NR
 7/2 Spud 5-12-52
 Oil Well TD 2439' 12" @ 487
 Anhy 855' 10" @ 860'
 Tar 2343 7" @ 2435 TD 2439
 B/ 38 goph PB 2437 40 goph
 FU 190' oil 9 hr. D-Hydro
 FU 850' oil 13 hr. S/ 40 bo 12 hr.
 Comp. 65 bopd 5 bw

COMPLETED

County Russell State Kansas
 Sec. 11 (Blk. 15) (Sur. 14W) (Twp.) (Rge.) Map No.
 Operator N C R A
 Well No. 12 Farm Flegler "C"
 Elev. 1865 Location NW NE NE

330 Ft. From N Line NE
990 Ft. From E Line Quarter
 Ist. Report
 Completion JUL 2 1952
 Remarks Trapp Pool

COMPLETE

Spudding Date 5-12-52

Drlg. Data Oil well TD 2439
12" @ 487 Anhy 855 10" @ 860
Tarkio 2343 7" @ 2435 TD 2439
B/ 38 goph PB 2437 40 goph
FU 190' oil 9 hr. D-Hydro. FU 850'
oil 13 hr. S/ 40 bo 12 hr.
Comp. 65 bopd 5 bw

