


Section 19 Township 14 Range 13W

Well No. #4 Rein

Company Gleason & Haynes

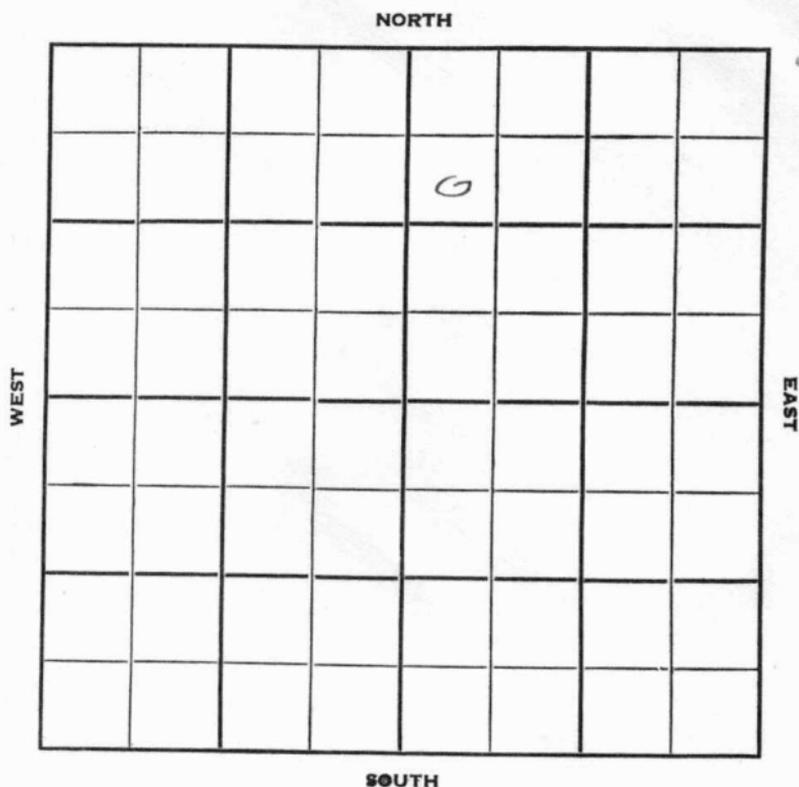

Sec. 19 Twp. 14 R. 13W

Well No. #4 Rein Farm

Gleason & Haynes Company

Gleason Contractor

Hall Gurney


990 Ft. from N. Line

Ft. from S. Line

Ft. from E. Line

330 Ft. from W. Line

SW NW NE

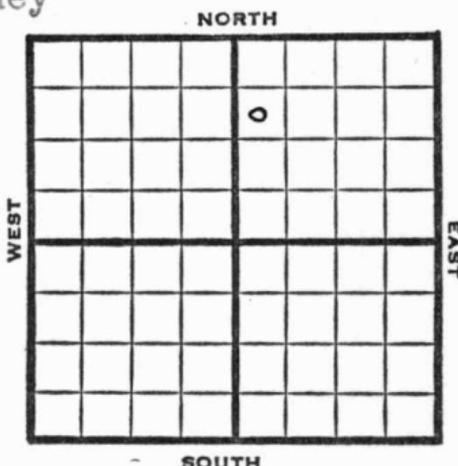

1952 Elev. 1777' REPORT

3/26 RUR CT
4/1 10" @ 20'
Drlg. 300'

4/9 8" @ 393'
Anhy 742
7" @ 736'
Drlg. 815'

4/23 Drlg. 2190'

4/30 SO 2303 Tarkio 2317 TD 2322
5" @ 2318 DP CO 2322 B/5 gal oph
Hydr.

5/7 Spud 3-27-52
Oil well TD 2322' 10" @ 20
8" @ 393 Anhy 742' 7" @ 736
Tarkio 2317' TD 2322' 5" @ 2318
CO to 2322' B/5 GOPH Hydro
DD 2324' Hydro. S/5 BOPH
Comp. 50 BOPD

COMPLETED

County **Russell** State **Kansas**

Sec. **19** (Blk. Twp.) **14** (Sur. Rge.) **13W** Map No.

Operator **Gleason & Haynes**

Well No. **4** Farm **Rein**

Elev. **1777** Location **SW NW NE**

		o		

COMPLETE

990 Ft. From **N** Line **NE**

330 Ft. From **W** Line **Quarter**

Ist. Report

Completion **MAY 7 1952**

Remarks **Hall-Gurney Pool**
Gleason - Contr.

Spudding Date **3-27-52**

Drlg. Data **Oil well TD 2322**

10" @ 20 8" @ 393 Anhy 742 7" @ 736

Tarkio 2317 TD 2322 5" @ 2318

CO to 2322 B/ 5 goph Hydro. DD 2324

Hydro. S/ 5 boph Comp. 50 bopd

J. G. McGEHEE