


Russell 14 XV

Section 11 Township 14 15 Range 15-W

Well No. #9 Fleegeer "C"

Company NCRA

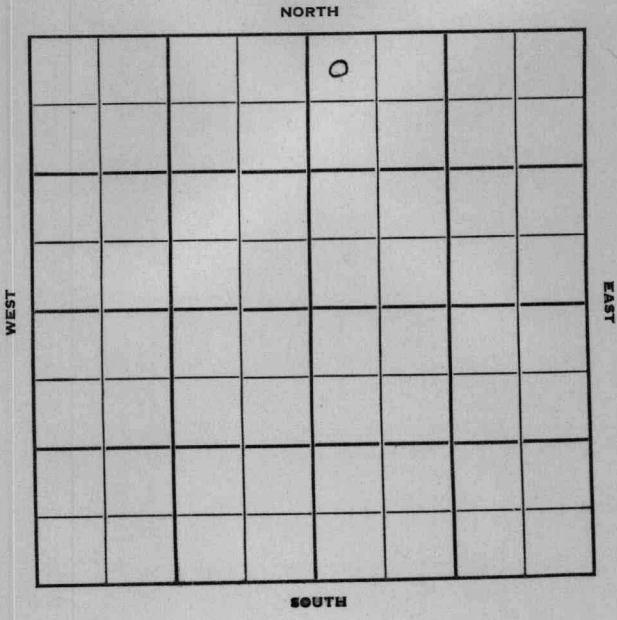

Sec. 11 Twp. -14-12- R. 15-W/4W

Well No. #9 Fleeger "C" Farm

N C R A

Company

Contractor


330 Ft. from N. Line

Ft. from S. Line

Ft. from E. Line

290 ~~330~~ Ft. from W. Line

NW NW NE

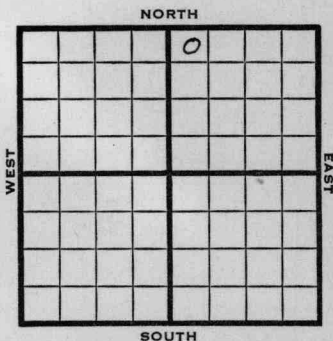

1950

Elev 1747

REPORT

8/2

Rig Up

9/6

Spud 8-11-50

12 1/2" @ 35

10" @ 377

8 5/8" @ 773

Anhy 752

Tarkio 2325

TD 2355

D&A

ABANDONED

Kansas

Map No. _____ Sec. 11 Twp. 14 R. 15^WWell No. 9 Fleegeer "C"N C R A

Company _____

Contractor _____

NW NW NE

SECTION PLAT

330 Ft. from N. Line

_____ Ft. from S. Line

_____ Ft. from E. Line

330 Ft. from W. Line

Russell County

Location _____

Rig up X

Drilling and Remarks:

RECORD

Cased _____ in., _____ ft.

Sand _____

Gas _____

Oil _____

Total Depth _____

PRODUCTION

1st 24 hrs. Nat. _____

1st 24 hrs. after shot _____

Gas _____ Cu. Ft.

Dry Hole _____

Abandoned _____

Date

AUG 2 1950

19

J. E. TYRA

Scout

Map No. _____ Sec. 11 Twp. 15 R. 14W

Well No. 9 Fleegeer "C"

N C R A

Company _____

CORRECTION

Contractor _____

NW NW NE

SECTION PLAT

330 Ft. from N. Line

_____ Ft. from S. Line

_____ Ft. from E. Line

380 Ft. from W. Line

		0	

Russell County

Location _____

Rig up _____

Drilling and Remarks:

Reported

11-14-15W

RECORD

Cased _____ in., _____ ft.

Sand _____

Gas _____

Oil _____

Total Depth _____

PRODUCTION

1st 24 hrs. Nat. _____

1st 24 hrs. after shot _____

Gas _____ Cu. Ft.

Dry Hole _____

Abandoned _____

Date

AUG 9

1950 19

J. E. TYRA

Scout


We show a completed Oil well at this spot. Same feet measurements and spot. It is a #2 well.

What do you want to do with this #2 well? We have to move it some place if you put No. 9 well here

Advise

Sam

SECTION PLAT

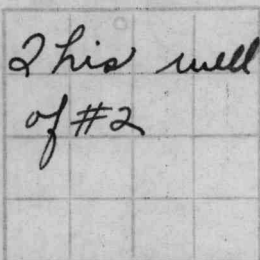

330. Ft. from N. Line
 330. Ft. from S. Line
 330. Ft. from E. Line
 330. Ft. from W. Line

Russell County

RECORD

Cased in _____
 Sand _____
 Gas _____
 Oil _____
 Total Depth _____

Location

Rig up

Drilling and Remarks

AUG 10 1950
 7 W 7

Scout Cards	7 W 7
Land Small Map	
Land Wall Map	
Tracings	
France Map	
Pierce Map	
Misc.	

Date

Scout AUG 8 1950



(Blk.)
(Twp.)

N C R A

Fleeger "C"

50' W #2

ABANDONED

290

1st. Report

Remarks

Trapp Pool

Spudding Date 8-11-50

D & A

TD 2355

Anhy 752 Tarkio 2325 TD 2355

D & A

Current C.
290.

J. E. TYRA