

KANSAS

Russell

Section 16 Township 14 Range 13W

Well No. #4 Dumler

Company Lee Phillips

NORTH

16

WEST

EAST

| | | | | | | | |
|--|--|--|--|--|--|--|---|
| | | | | | | | |
| | | | | | | | |
| | | | | | | | |
| | | | | | | | |
| | | | | | | | |
| | | | | | | | |
| | | | | | | | |
| | | | | | | | 0 |

SOUTH

Sec. 16 Twp. 14 R. 13 W

Well No. # 4 Dumler Farm _____

Lee Phillips Company _____

Contractor _____


_____ Ft. from N. Line

330 Ft. from S. Line

330 Ft. from E. Line

_____ Ft. from W. Line

SE SE SE

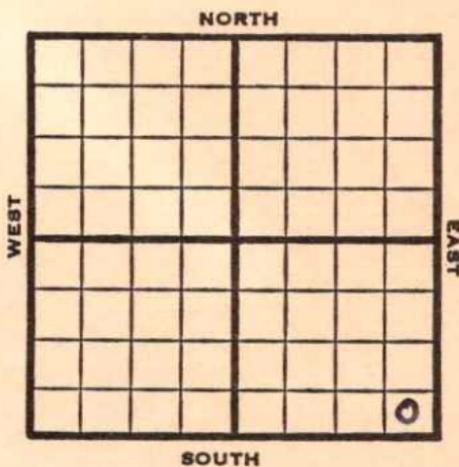

1953

Elev. 1841'

REPORT

3/18

RUCT

3/26

Drlg. 200'

4/2

Anhy 775 8" @ 775

Drlg. 1325

4/9

Drlg. 2305

4/16

Tarkio 2365

7" @ 2365

DD 2370 30 goph

4/22

Spud 3-22-53 Oil well TD 2370


Anhy 775' 8" @ 775 Tarkio 2365

7" @ 2365 TD 2370 30 GOPH

sd-frac.

Comp. 50 BOPD

COMPLETED

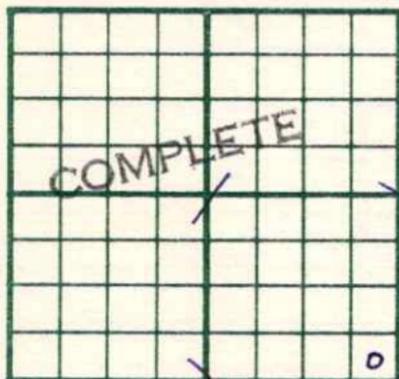County Russell State KansasSec. 16 (Blk.
Twp.) 14 (Sur.
Rge.) 13W Map No.Operator Lee PhillipsWell No. 4 Farm DumlerElev. 1841 Location SE SE SE330 Ft. From S Line SE330 Ft. From E Line Quarter

1st. Report

Completion APR 22 1953

Remarks

Spudding Date 3-22-53Drig. Data Oil well TD 2370Anhy 775 8" @ 775 Tarkio 23657" @ 2365 TD 2370 30 goph sd-fracComp. 50 bopd