


Section 11 Township 15 Range 14W

Well No. #11 Flegler "C"

Company N C R A

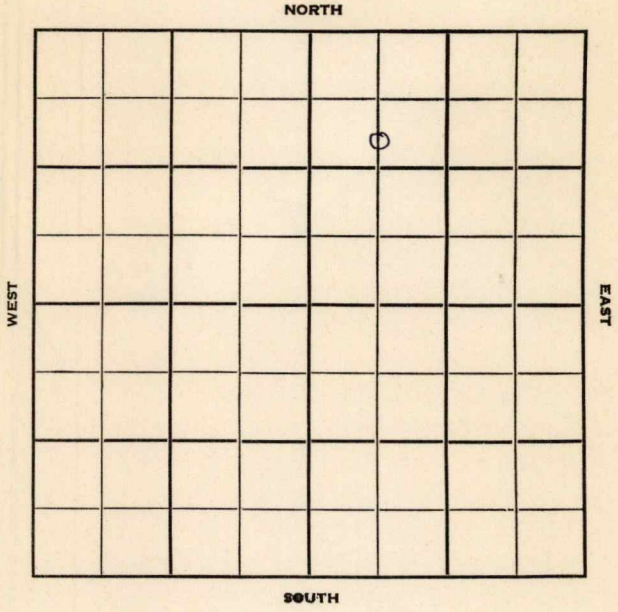

Sec. 11 Twp. 15 R. 11 W

Well No. # 11 Flegler "C" Farm

N C R A Company

Brunson Drlg. Contractor

Trapp Pool


990 Ft. from N. Line

Ft. from S. Line

Ft. from E. Line

660 Ft. from W. Line

C S L N W N E

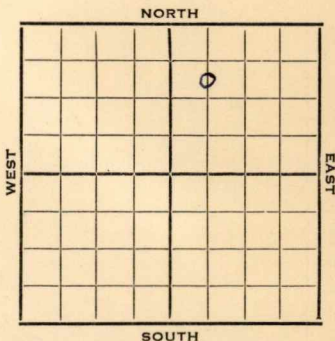

1951

Elev. 1768'

REPORT

Elev. 1754 corr.

12/5

Spud 11-29-51

8" @ 764'

Anhy 764-93'

Drlg. 1760'

1952

2/6

TD 3203' 5" @ 3202

PB 3208 POP

2/13

No report

2/20

Spud 11-29-51

8" @ 764 Oil Well TD 3216

Anhy 764-93 Heeb. 2879

Dodge 2895 KC 2939

DST 2941-90 opn 2 hr. Rec. 190' ocm

Arb. 3201-03 5" @ 3202 TD 3208

B/2 boph 2 hr. 500 A FU 2400' fluid

15 hr. DD 3216 S/11 bo 111 bw 6 hr

wtr PB 3208 P/231 bfpd 91% wtr

PB 3205 250A P/89 bf 12 hr.

80% wtr P/20 bf 8 hr. 67% wtr.

Comp. 60 bopd 67% wtr.

COMPLETED

