


Section 19 Township 14 Range 13W

Well No. #2 Rein

Company Fred Haynes

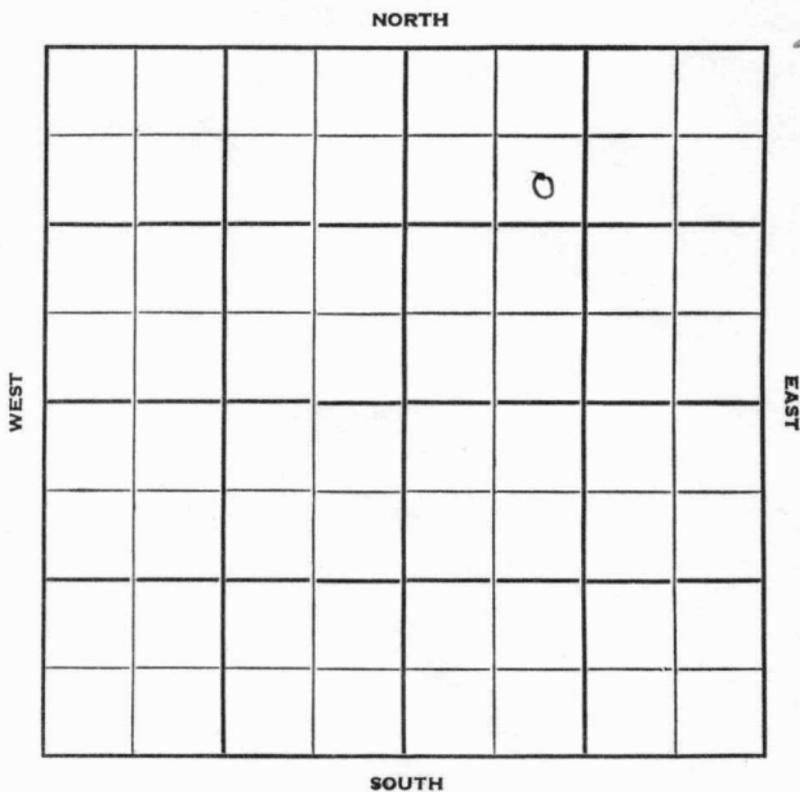


Sec. 19 Twp. 14 R. 13-W

Well No. #2 Rein Farm
Fred Haynes Company

Hall-Gurney Contractor

990 Ft. from N. Line
 Ft. from S. Line
 Ft. from E. Line
990 Ft. from W. Line

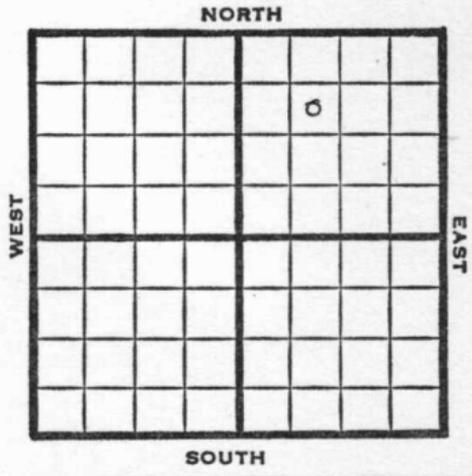

SE NW NE

1950 Elev. 1790' REPORT

10/11 RUR

12/6 Spud 10-10-50
Oil Well TD 2353
10" @ 348' 8" @ 775
Tarkio 2321-42
5" @ 2325
TD 2353 PB 2340
6 goph Hydrofrac S/3-3/4 boph
2000 A Comp. 4 1/2 bopd

COMPLETED

