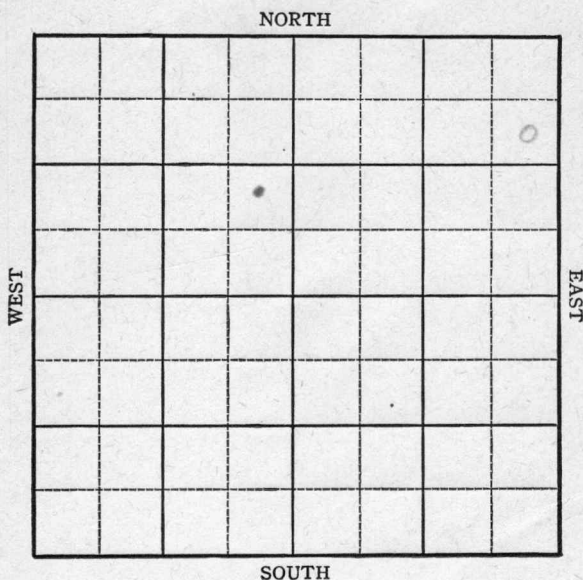


KANSAS

Russell

Section 19 Township 14 Range 13WWell No. 2 ReinCompany Eldorado Ref.

KANSAS

Russell

Sec. 19 Twp. 14 R. 13-W

Well No. #2 Rein Farm


Eldorado Ref. Company

990 Ft. from N. Line

 Ft. from S. Line

330 Ft. from E. Line

 Ft. from W. Line

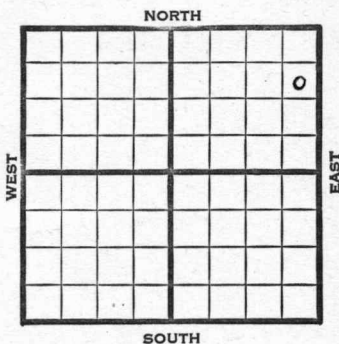

SE NE NE Elev. 1799

1945

REPORT

8/1

8" @ 271'

Drlg. 1866'

8/8

Lans 2945

Drlg. 3131

8/15

Gorham 3223

5" @ 3223

Arb. 3237

Reagan 3257

TD 3262 HFW

PB

8/22

" " "

8/29

Reagan 3257

5" @ 3257

TD 3262

ABANDONED

MINASAS**Kansas**Pool Name Hall-GurneyMap No. 72 Sec. 19 Twp. 14 R. 13WWell No. 2 Rein

Eldorado Ref.

Company

FIRST REPORT

Contractor

SE NE NE

SECTION PLAT990 Ft. from N. Line

Ft. from S. Line

330 Ft. from E. Line

Ft. from W. Line

			o

Russell County

Location

Rig up

Drilling and Remarks:

8"-271

1866

RECORD

Cased _____ in., _____ ft.

Sand _____

Gas _____

Oil _____

Total Depth _____

PRODUCTION

1st 24 hrs. Nat. _____

1st 24 hrs. after shot _____

Gas _____ Cu. Ft.

Dry Hole _____

Abandoned _____

Date

AUG 1 1945

19

S. J. LEWIS

Scout

KANSAS

Kansas Pool Name Hall-GurneyMap No. 72 Sec. 19 Twp. 14 R. 13WWell No. 2 ReinEldorado R.o.f. Company**ABANDONED** Contractor

SE NE NE

E 11/1989
SECTION PLAT990 Ft. from N. Line Ft. from S. Line330 Ft. from E. Line Ft. from W. Line

			6

Russell CountyLocation Rig up

Drilling and Remarks:

Reagan 325?
5-K 325?**RECORD**Cased in., ft.Sand Gas Oil Total Depth 3262**PRODUCTION**1st 24 hrs. Nat. 1st 24 hrs. after shot Gas Cu. Ft.Dry Hole Abandoned

Date

AUG 29 194519S. J. LEWISScout