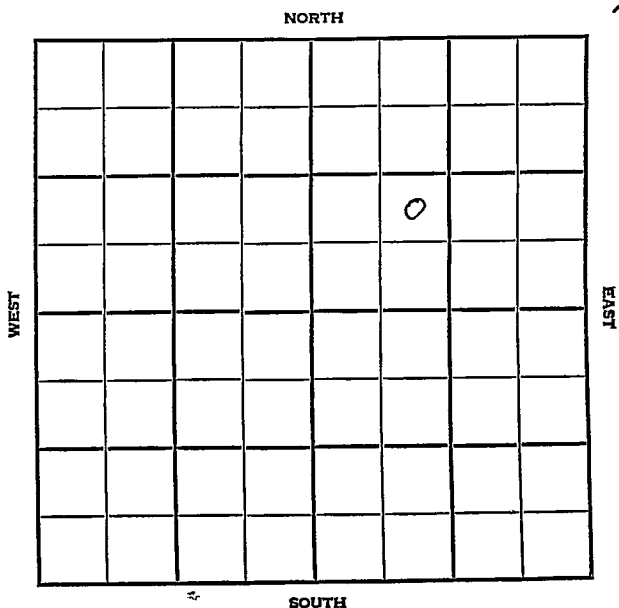


Section 4 Township 34 Range 3 EWell No. #2 AbramsCompany Aladdin Pet.

Cowley

KANSAS

SEC.	TWP.	R.
4	34	3E

WELL NO.

#2 Abrams

FARM

COMPANY

Aladdin Pet.

CONTRACTOR

Crowe Drlg.

Gueda Springs


Ft. from N. Line

Ft. from S. Line

Ft. from E. Line

Ft. from W. Line

NE SW NE

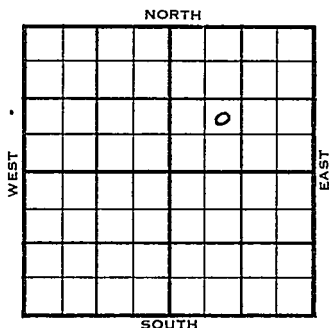


1955	ELEVATION	REPORT
8/17	1122	
	Comm 8-12-55	
	8" @ 143	
	Drlg 1270	
8/31	Comm 3-12-55	
	Layton	2654 2654
	KC	2808 2802
	BKC Marm	2992 3003
	Ce	3120
	M	3334 3344
	M B	3680
	S	3737
	S sd	3768
	A	3782
	TD	3809
	8" @ 143	
	DST 3744-72	open 20 min
	Rec 3' mud	0/15"
	D & A	
	ABANDONED	

County Cowley Elev. 1122 Co.
 Sec. 1 Twp. 34 Rge. 3E
 Company Aladdin Pet.
 Farm Name Abnema No. 2

TOPS	DEPTH	LOG	DATUM	Loc. in Sec.
Anh.				NE SW NE
Tr.				
Dg.				
BL.				
L.				
K.C.				Geol.
B.K.C.				Contr.
Ce.				Crown Drlg.
C.				Pool
M.				Gueda Springs
K.				
Mz.				
Me.				
V.				
S.				
S.				
A.				
R.				
Pe.				
G.				
T.D.				

Date Comm. 8-12-55
8" @ 143 drlg. 1270

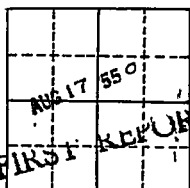

Co.

Lse.

No.

Sec.

T.

R.

County

~~Cowley~~

Elev.

1122

Sec.

1

Twp.

34

Rge.

3E

Company

Aladdin Pet.

Farm Name

Abrams

No.

2

TOPS

DEPTH

LOG

DATUM

Loc. in Sec.

Anh.

Tp. Lantern

H.

Tr.

Dg.

Bl.

L.

K.C.

B.K.C. Marm

Ce.

C.

M.

M.

K.

Mz.

Mo.

V.

S.

S.

A.

R.

P.E.

G.

T.D.

2154

2154

1532

NE SW NE

2808

2802

1680

Geol.

2992

3003

1881

Contr.

3120

Crowe Drlg.

3334

3344

2222

Pool

3680

2558

Gueda Springs

3787

3768

3615

3782

3646

3646

ABANDONED

2809

Date Comm. 8-12-55

AUG 31 1955

8" @ 143

DST 3744-72

open 20 min.

Rec. 3' mud 0/15"

D & A