


Section 16 Township 14 Range 13W

Well No. #6 Dumler

Company Lee Phillips

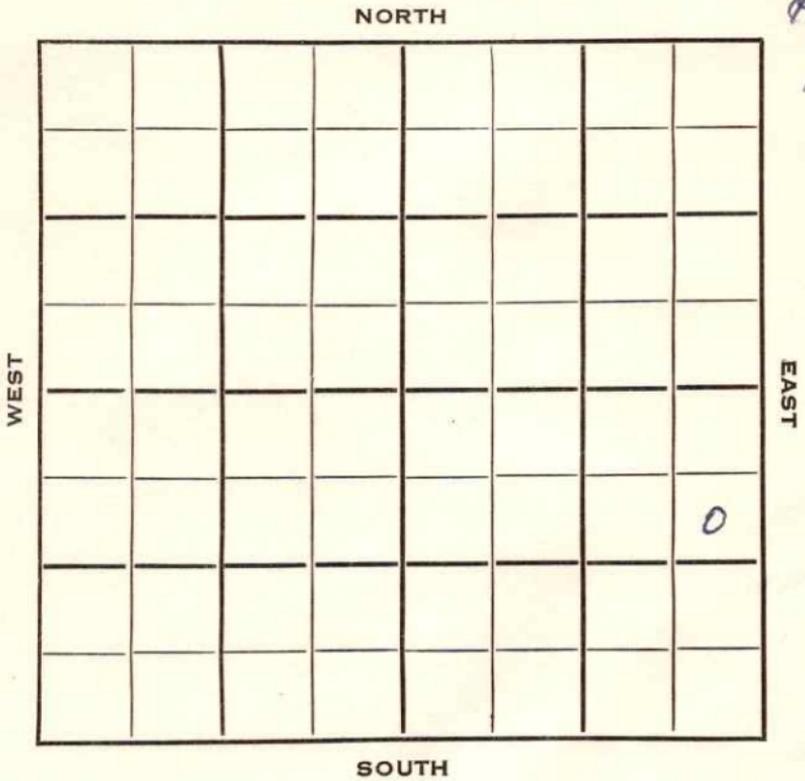

Russell

KANSAS

SEC.	TWP.	R.
16	14	13 W

WELL NO. # 6 Dumler FARM

COMPANY Lee Phillips


CONTRACTOR Mast Drlg. & Hall-Gurney Pool

990 Ft. from N. Line

Ft. from S. Line

330 Ft. from E. Line

Ft. from W. Line

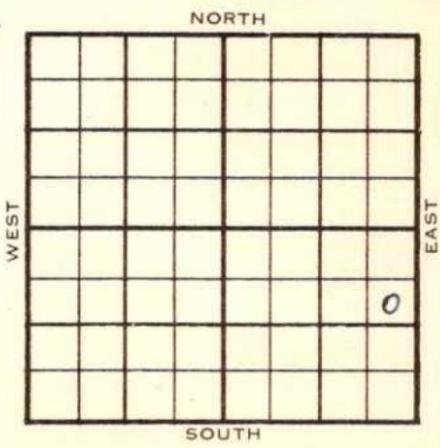

SE NE SE

	ELEVATION	REPORT
1954	1831'	

1/27 Spud 1-23-54  
8" @ 235 Anhy 781'  
Drlg. 825'

2/3 Tarkio 2379' RTD 2393' 5" @ 2392

2/10 DD 2404' NS  
DD 2406 TD  
60/2371-75, sd-frac

3/10 Spud 1-23-54 Oil well TD 2406  
8" @ 235 Anhy 781 Tarkio 2379  
TD 2393 5" @ 2392 DD 2404 DD 2406  
60/2371-75 sd-frac S/3 BOPH 12 HE.  
Comp. 25 BOPD

**COMPLETED**



