

Section 19 Township 14 Range 13W

Well No. 3 Rein


Company Eldorado Ref.

Hall-Gurney Pool

NORTH

WEST

EAST

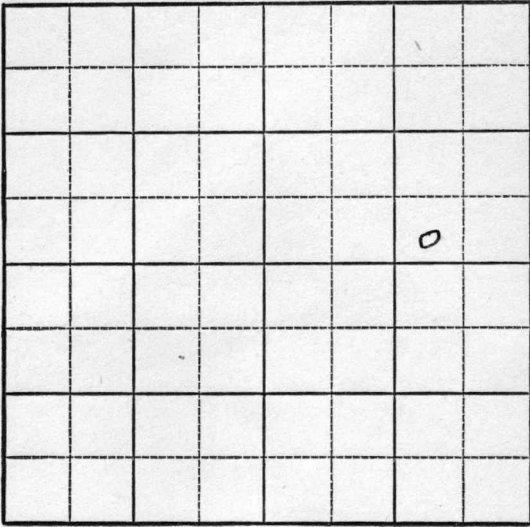

SOUTH

Sec. 19 Twp. 14 R. 13-W ✓

Well No. #3 Rein Farm


Eldorado Ref. Company

_____ Ft. from N. Line

330 Ft. from S. Line

990 Ft. from E. Line

_____ Ft. from W. Line

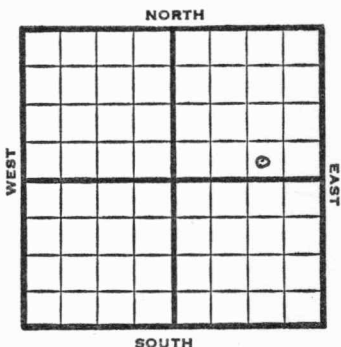

SW SE NE

1948

Eli 1792'

REPORT

10/6

Location

10/6

"

10/13

"

10/19

Rig

10/26

"

11/3

"

11/10

"

11/16

"

11/23

"

11/30

"

12/8

Drlg 225

12/15

10" @ 779'

Drlg 825'

12/22

Drlg 1450'

12/29

Drlg 2200'

1/5

8# @ 2460'

Drlg. 2525'

1/12

Lansing 2940 Drlg 3035

1/19

TD 3254'

Arb. 3219'

Aband.

ABANDONED

Map No. _____ Sec. 19 Twp. 14 R. 13W

Well No. 3 Rein

_____ Eldorado Ref. _____ Company

_____ **FIRST REPORT** _____ Contractor

SW SE NE

SECTION PLAT

| | | | |
|--|--|--|---|
| | | | |
| | | | o |
| | | | |
| | | | |
| | | | |

_____ Ft. from N. Line

330 Ft. from S. Line

990 Ft. from E. Line

_____ Ft. from W. Line

Russell County

RECORD

Location X

Rig up _____

Drilling and Remarks:

Cased _____ in., _____ ft.

Sand _____

Gas _____

Oil _____

Total Depth _____

PRODUCTION

1st 24 hrs. Nat. _____

1st 24 hrs. after shot _____

Gas _____ Cu. Ft.

Dry Hole _____

Abandoned _____

Date

OCT 6 1948 19

S. J. LEWIS Scout

