

Cowley


FORM 51

KANSAS

Section 4 Township 34 Range KANSAS E

Well No. #1 Beeks

Company McNeish & Gralapp

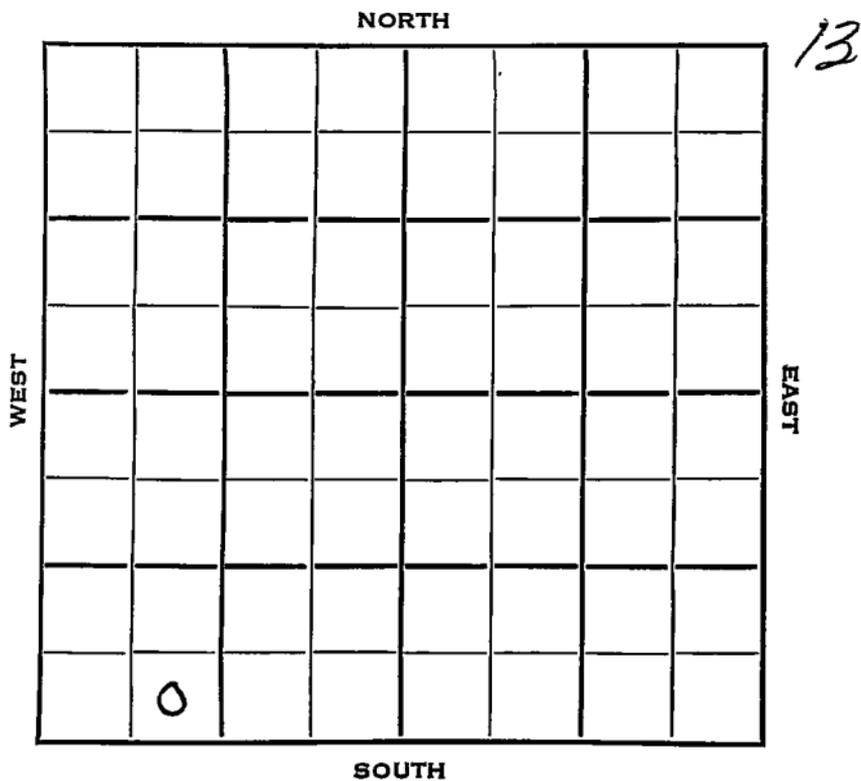

Cowley KANSAS


SEC.	TWP.	R.
4	34	3E ✓

WELL NO. I Beeks FARM

COMPANY McNeish & Gralapp

CONTRACTOR Watson Drig.  
Harvey Pool

\_\_\_\_\_ Ft. from N. Line  
330 \_\_\_\_\_ Ft. from S. Line  
\_\_\_\_\_ Ft. from E. Line  
990 \_\_\_\_\_ Ft. from W. Line

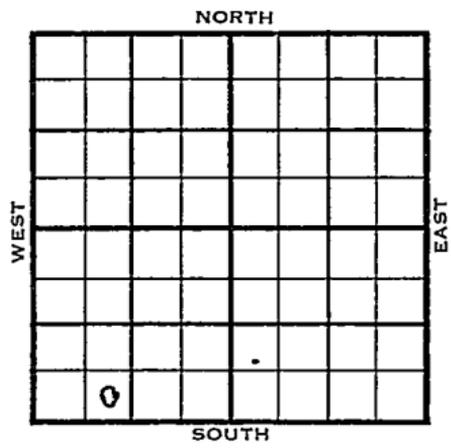

SE SW SW

1953	ELEVATION 1096'	REPORT
------	-----------------	--------

12/9 Location  
2/24 Spud 1-3-54  
D & A  
TD 3347'  
8" @ 90'  
Layton 2609'; KC 2806', Peru 2948'  
Oswego 2992', Miss 3320'  
TD 3347'  
5" @ 2996'  
40/ 2949-55 HFW  
D & A  
**ABANDONED**



County Cowley State KANSAS

Sec. 4 (Blk. 34 (Sur. 3E (Twp.) 34 (Rge.) 3E Map No.

Operator McNeish & Gralapp

Well No. 1 Farm Beeks

Elev. 1096 Location SE SW SW


330 Ft. From S Line SW

990 Ft. From W Line Quarter

Ist. Report

Completion r t h 2 4 1954

Remarks Harvey Pool

Watson Drlg. - Contr.

Spudding Date 1-3-54

Drlg. Data D & A TD 3347

8" @ 90 Layton 2609 KC 2806

Peru 2948 Oswego 2992 Miss. 3320

TD 3347 5" @ 2996 40/ 2949-55 HFW

D & A