


KANSAS

Ellis County

Section 18 Township 13 Range 19W

Well No. #1 Disney 22 Strat

Company Continental

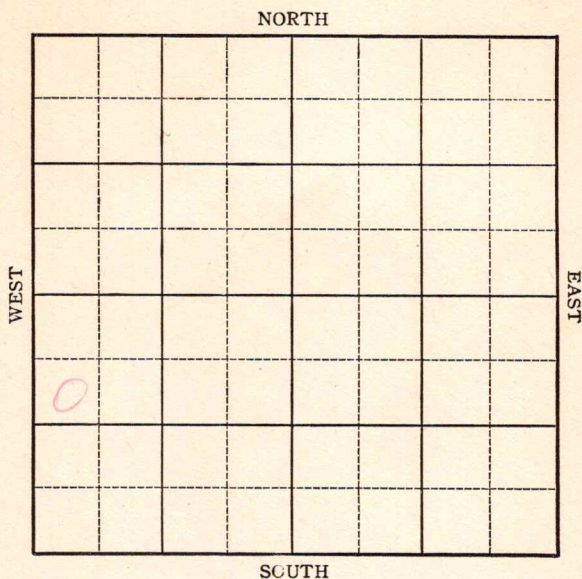

KANSAS

Ellis County

Sec. 18 Twp. 13 R. 19W

Well No. #1 Disney 22 Strat Farm

Continental

Company

Wildcat


990 Ft. from N. Line

Ft. from S. Line

Ft. from E. Line

330 Ft. from W. Line

SW NW SW

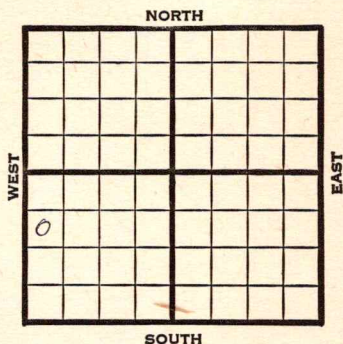

1945

REPORT

Elev. 2074 Gr.

8/2

Anhy	1408
Topeka	3128
Lans	3407
SSO	3431-3435, 3458-3462, 4
	3565-3567
Cong	3728
Arb	3780
TD	3803

FIRST REPORT
&

ABANDONED

Kansas Pool Name WildcatMap No. 70 Sec. 18 Twp. 13 R. 19WWell No. 1 Disney 22 stratContinental

Company

FIRST REPORT andABANDONED

Contractor

SW NW SW

E 12074 Gr

SECTION PLAT

990 Ft. from N. Line Ft. from S. Line Ft. from E. Line330 Ft. from W. Line

0			

Ellis CountyLocation Rig up

Drilling and Remarks:

anhy 1408Topeka 3128Lens 3407SSO 3431-35,
3458-62, 3565-
67Cong 3728Arb. 3780 D &

RECORD

Cased in., ft.Sand Gas Oil Total Depth 3803

PRODUCTION

1st 24 hrs. Nat. 1st 24 hrs. after shot Gas Cu. Ft.Dry Hole Abandoned

Date

MAY 2 194519S. J. LEWISScout