

Ellis


FORM 51

KANSAS

Section 20 Township 13 Range 19W

Well No. #1 Bemis

Company Mallonee Drlg.

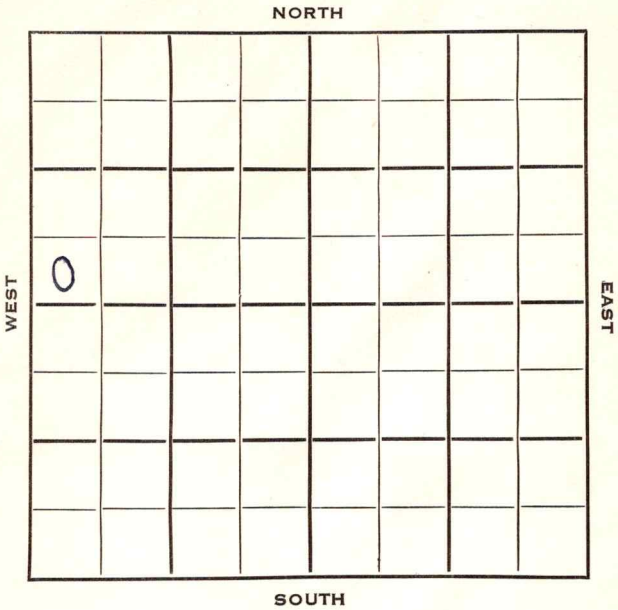

Ellis

KANSAS

SEC.	TWP.	R.
20	13	19 W ✓

WELL NO.

1 Bemis

FARM

COMPANY

Mallonee Drlg.

CONTRACTOR

Mallonee Drlg.


Wildcat

Ft. from N. Line

Ft. from S. Line

Ft. from E. Line

Ft. from W. Line

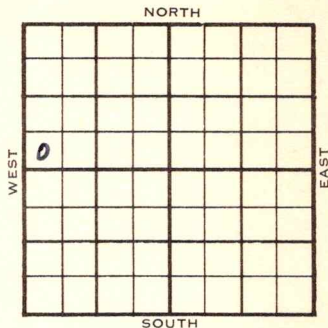

SW SW NW

Texas - DHM

	ELEVATION	REPORT
1953	2084'	

10/7

Spud 9-29-53

8" @ 195' Anhy 1410'

Drlg. 2875'

10/14

Spud 9-29-53

D&A

TD 3810'

8" @ 195'

Anhy 1410', Top 3162'

DST 3162-73, opn 1/2 hrs., rec. 20' mud, 0#

Heeb 3373', Tor 3394', KC 3417'

DST 3493-3505, opn 1 hr., rec. 25'

socm, 100' wcm, 975#

B KC 3668', Marm 3708'

DST 3713-34, opn 1 hr., rec. 75'

o & gcm, 300#

Arb. 3779'

TD 3810

D&A

ABANDONED

County Ellis State Kansas

Sec. 20 (Blk. Twp.) 13 (Sur. Rge.) 19W Map No.

Operator Mallonee Drlg.

Well No. 1 Farm Bemis

Elev.	Location	SW	SW	NW
-------	----------	----	----	----

330 Ft. From S Line NW

330 Ft. From W Line Quarter

1st. Report OCT 7 1953

Completion

Remarks Texas - DHM

Mallonee Drlg. - Contr.

Spudding Date 9-29-53

Drlg. Data Wildcat

8" @ 195 Anhy 1410 drlg. 2875

County Ellis State Kansas
 Sec. 20 (Blk.) 13 (Sur. Rge.) 19W Map No. _____
 Operator Mallonee Drlg.
 Well No. 1 Farm Bemis
 Elev. 2084 Location SW SW NW



330 Ft. From S Line NW
330 Ft. From W Line Quarter

1st. Report _____

Completion OCT 14 1953

Remarks Wildcat

Mallonee Drlg. - Contr.

Spudding Date 9-29-53

Drlg. Data D & A TD 3810

8" @ 195 Anhy 1410 Top. 3162

DST 3162-73 open $\frac{1}{2}$ hr. Rec. 20' mud

0# Heeb. 3373 Tor. 3394 KC 3417

DST 3493-3505 open 1 hr. Rec. 25' socm

100' wcm 975# B KC 3668 Marm. 3708

DST 3713-34 open 1 hr. Rec. 75' o & gcm

300# Arb. 3779 TD 3810

D & A