


Section 19 Township 14 Range 13 W

Well No. #6 Rein (A)

Company Lindas Oil

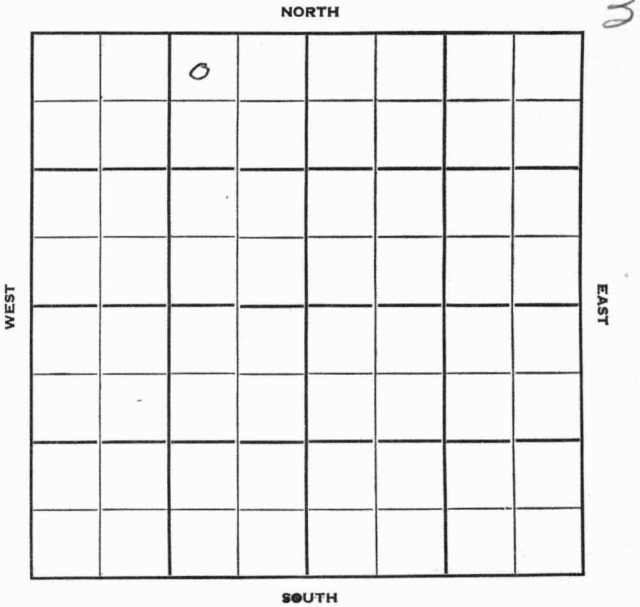

Russell

KANSAS

Sec. 19 Twp. 14 R. 13

Well No. #6 Rein (A) Farm

Lindas Oil Company

Hall Gurney Contractor


330 Ft. from N. Line

_____ Ft. from S. Line

990 Ft. from E. Line

_____ Ft. from W. Line

NW NE NW-

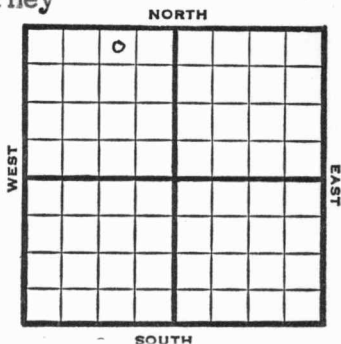

1952

Elev. 1798' REPORT

1/16 Cellar & Pits
2/6 Drlg. 1100'
2/13 8" 765
Drlg. 2080'
2/20 Torkio 2341' 5" @ 2342'
TD 2350' B/10 gal oil per hr.
To Hyd.
3/5 Spud 1-25-52
Oil Well TD 2350
15" @ 37 10" @ 455
Anhy 749 8" @ 765
Tarkio 2341 5" @ 2342
TD 2350 B/10 goph Hydra
S/14 boph 4 hr. Comp. 50 bopd

COMPLETED

County **Russell** State **Kansas**
Sec. **19** (Blk.) **14** (Sur.) **13** Map No.

Operator **Lindas Oil**

Well No. **6** Farm **Rein (A)**

Elev. Location **NW NE NW**

FIRST REPORT

330 Ft. From **N** Line **NW**

990 Ft. From **E** Line Quarter

1st. Report **JAN 16 1952**

Completion

Remarks

Spudding Date

Drlg. Data

Hall Gurney

Cellar & Pits

J. E. TYRA

County Russell State Kansas
 Sec. 19 (Blk. 14) (Sur. 13W) (Rge.) Map No.
 Operator Lindas Oil
 Well No. 6 Farm Rein "A"
 Elev. 1798 Location NW NE NW

330Ft. From N Line NW

990Ft. From E Line Quarter

1st. Report

Completion MAR 5 1952Remarks Hall-Gurney PoolSpudding Date 1-25-52Drig. Data Oil well TD 235015" @ 37 10" @ 455 Anhy 749 8" @ 765Tarkio 2341 5" @ 2342 TD 2350 B/ 10goph Hydro. S/ 14 boph 4 hr.Comp. 50 bopd