


Section 19 Township 14 Range 13W

Well No. 7 Rein "A"

Company N C R A

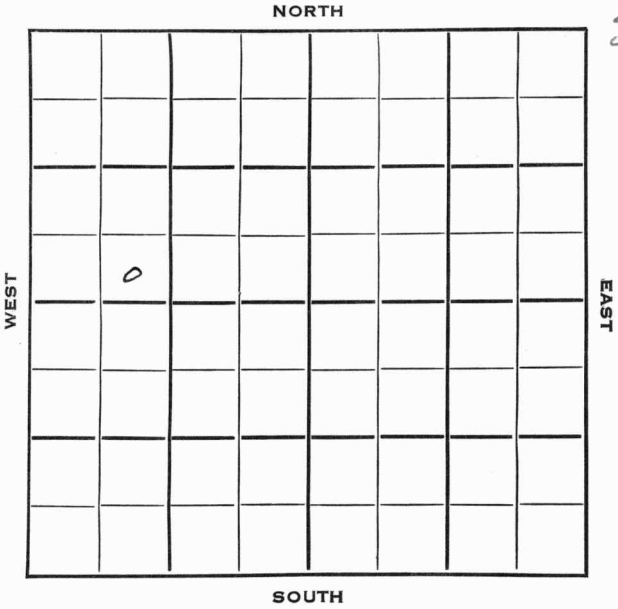

Sec. 19 Twp. 14 R. 13W

Well No. 7 Rein "A" Farm

N C R A Company

Murfin Drlg. Contr. Contractor


Ft. from N. Line

330 Ft. from S. Line

Ft. from E. Line

990 Ft. from W. Line

SE SW NW

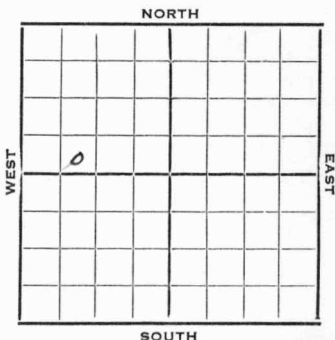

1953 Elev. 1781' REPORT

1/7 MIR

1/22 8" @ 225 Anhy 759' Tarkio 2306'
RTD 2442' Schl 5" @ 2441'

1/29 CO 2409, 44/2381-92, st-frac,
S/3 1/2 BW + 1 1/2 BOPH 7 hrs.
PB 2370, 24/2323-29
B/10 GO + 2 BWPH 6 hrs.

2/5 Testing

2/11 Spud 1-7-53
Oil Well
TD 2442
8" @ 225
Anhy 759, Tarkio 2306,
TD 2442, 5" @ 2441, CO to 2409
44/2381-92, st-frac S/3 1/2 bw 1 1/2
boph 7 hrs.
PB 2370
24/2323-29, B/10 go 2 gwph
6 hrs., B/10 go 1 1/2 gwph 12 hrs.
st-frac, S/4 1/2 boph 10% wtr.
6 hrs.
CO to 2369, S/5 1/2 bfph 16% wtr.
Comp. 91 bopd

COMPLETED

County Russell State Kansas

Sec. 19 (^{Blk.}_{Twp.}) 14 (^{Sur.}_{Rge.}) 13W Map No.

Operator N C R A

Well No. 7 Farm Rein "A"

Elev. 1781 Location SE SW NW

330 Ft. From S Line NW

990 Ft. From W Line Quarter

1st. Report

FEB 11 1953

Completion

Remarks

Murfin Drlg. - Contr.

Spudding Date 1-7-53

Drlg. Data Oil well TD 2442

8" @ 225 Anhy 759 Tarkio 2306

TD 2442 5" @ 2441 CO to 2409 44/ 2381-

92 st-frac S/ 3½ bw 1½ boph 7 hr.

PB 2370 24/ 2323-29 B/ 10 go 2 gwph 6 hr

B/ 10 go 1½ gwph 12 hr. st-frac

S/ 4½ boph 10% wtr. 6 hr. CO to 2369

S/ 5½ bfph 16% wtr.

Comp. 91 bopd

