


Section 20 Township 14 Range 13-W

Well No. 1 A. C. Rogg "B"

Company Cities Service Oil

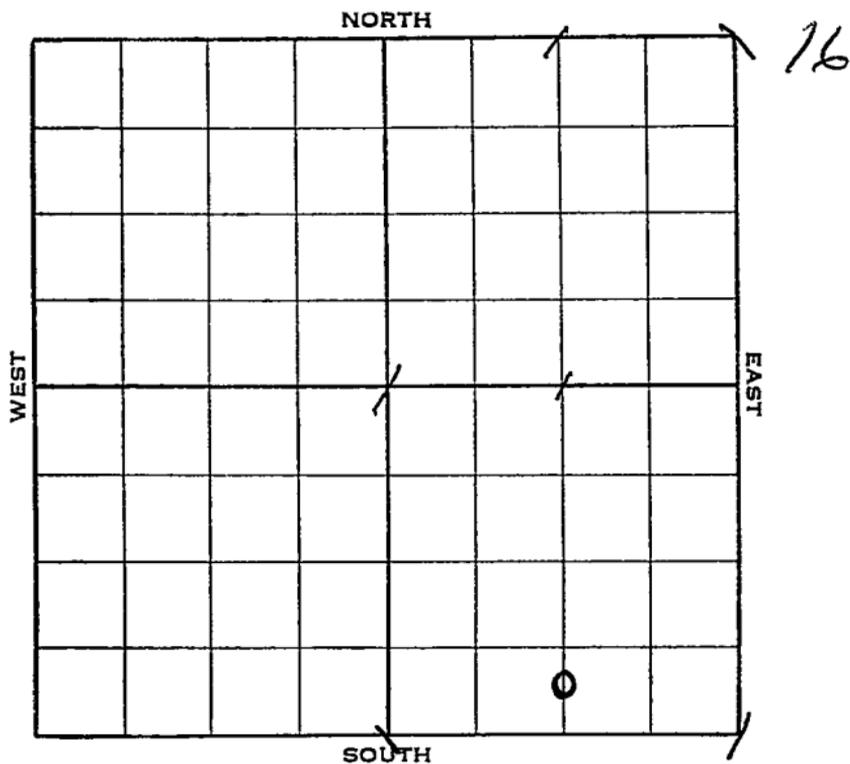


Sec. 20 Twp. 14 R. 13-WWell No. #1 A. C. Rogg "B" FarmCities Service Oil Company

_____ Ft. from N. Line

440 Ft. from S. Line1320 Ft. from E. Line

_____ Ft. from W. Line

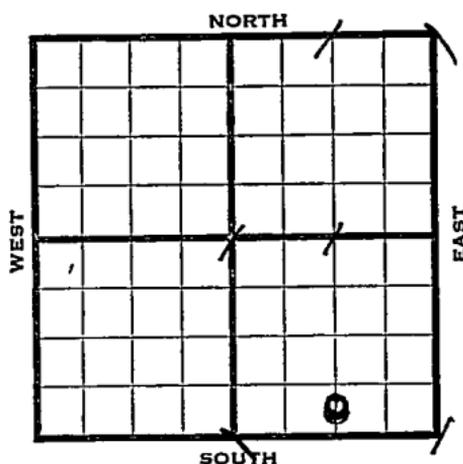

Elev. 1773

1938	REPORT
8/31	R U R
9/9	10" - 315'. Dlg. 1510'.
9/16	Topeka 2673'. Lans. 2926'. Dlg. 2954'.
9/23	S. O. 2928-31 & 2952-60'. Arb. 3196'. T.D. 3204' S.S.O. 7" - 3196'. RUST.
9/30	T. D. 3209'. H.F.W. P. B. 3073'.
10/7	Perf. 60 shots 2931-3015'. 9 bailers oil & 11 B.W. P. B. 3051'. 780' oil & 1½ B.W.
10/12	7" at 3196'. Lans. 2926'. Arb. 3196'. T. D. 3209'. H.F.W. P. B. 3051'. Perf. pipe 2931-3015'. 8000 acid. Potential 1287 bbls. No water.

COMPLETED

Russell


KANSAS

Map No. 72 Sec. 20 Twp. 14 R. 13WWell No. 1 A. C. Rogg "B"Cities Service Oil Company

Contractor

FIRST REPORT
C S L SE

SECTION PLAT

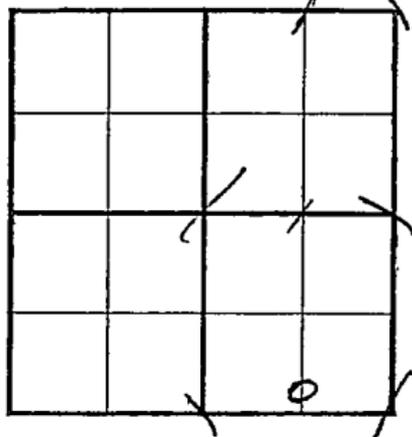 Ft. from N. Line440 Ft. from S. Line1320 Ft. from E. Line Ft. from W. LineLocation Rig up

Drilling and Remarks:

RUR

RECORD

Cased in., ft.Sand Gas Oil Total Depth

PRODUCTION

1st 24 hrs. Nat. 1st 24 hrs. after shot Gas Cu. Ft.Dry Hole Abandoned

Date

AUG 31 1938

19

H. D. Hatfield

Scout

Russell

KANSAS

Map No. _____ Sec. 20 Twp. 14 R. 13WWell No. 1 A. C. Rogg "B"Cities Service Oil Company

Contractor _____

COMPLETED

C S L SE

_____ Ft. from N. Line

440 Ft. from S. Line1320 Ft. from E. Line

_____ Ft. from W. Line

SECTION PLAT

			○

Location _____

Rig up _____

Drilling and Remarks:

*P.B. 3073
3051**Per F. pipe 2931-3015**8000 Acid**POT 1287**NO WTR***RECORD**Cased 7 in., 3196 ft.Sand LENS 2926Gas ATB 3196

Oil _____

Total Depth 3209 HFW**PRODUCTION**

1st 24 hrs. Nat. _____

1st 24 hrs. after shot _____

Gas _____ Cu. Ft.

Dry Hole _____

Abandoned _____

Date

OCT 12 1938 19

H. D. Hatfield Scout