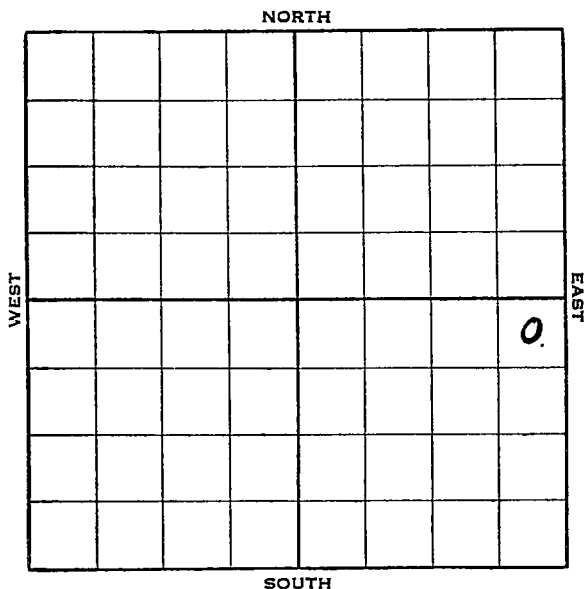


**O. W. P. B.****Barton****KANSAS**

FORM 51 5M 2-38 TPCO.

Section 12 Township 16 Range 14-WWell No. 3 Schneider "A"Company Shell

O. W. P. B. KANSAS Barton

Sec. 12 Twp. 16 R. 14-WWell No. #3 Schneider "A" FarmShell

Company

330


Ft. from N. Line

Ft. from S. Line

330

Ft. from E. Line

Ft. from W. Line

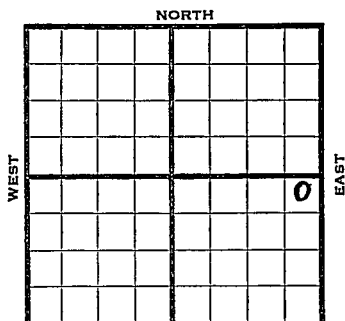Elev. 1916 *NENESE*

| 1938 | REPORT                              |
|------|-------------------------------------|
| 8/24 | Cellar.                             |
| 9/2  | 10" - 648'. WOC.                    |
| 9/9  | TD 2800'.                           |
| 9/16 | Topeka 2795'. Arb. 3333-35'.        |
|      | 7" - 3334'. RUST.                   |
| 9/21 | 7" - 3334'.                         |
|      | Arb. 3333'.                         |
|      | T. D. 3348'.                        |
|      | 4000 acid.                          |
|      | Potential 3017 bbls.                |
|      | COMPLETED                           |
| 1952 | O. W. P. B.                         |
| 6/18 | Lans. 3104' Arb. 3334' Prod.        |
|      | OTD 3348' 7" @ 3334' CO 3333'       |
|      | 12/3330/33 VSSO 250 A B/21 gal w    |
|      | 4 hrs. DO 3336' SW 250 A S/78 BW    |
|      | plus SSO 3 hrs. PB 3143' 28/3103-10 |
|      | SO 3000 A                           |
|      | P/19 BO plus 1 BWPD Comp.           |
|      | FIRST REPORT                        |
|      | COMPLETED                           |

Barton KANSAS

Map No. 73 Sec. 12 Twp. 16 R. 14WWell No. 3 Schneider "A"Shell

Company

Contractor

## FIRST REPORT

## SECTION PLAT

|  |  |  |   |
|--|--|--|---|
|  |  |  |   |
|  |  |  |   |
|  |  |  | 0 |
|  |  |  |   |

NE SE

330 Ft. from N. Line

Ft. from S. Line

330 Ft. from E. Line

Ft. from W. Line

Location \_\_\_\_\_

Rig up \_\_\_\_\_

Drilling and Remarks:

**Cellar**

## RECORD

Cased \_\_\_\_\_ in., \_\_\_\_\_ ft.

Sand \_\_\_\_\_

Gas \_\_\_\_\_

Oil \_\_\_\_\_

Total Depth \_\_\_\_\_

## PRODUCTION

1st 24 hrs. Nat. \_\_\_\_\_

1st 24 hrs. after shot \_\_\_\_\_

Gas \_\_\_\_\_ Cu. Ft.

Dry Hole \_\_\_\_\_

Abandoned \_\_\_\_\_

Date

AUG 24 1938 19 H. D. Hatfield Scout

Barton

KANSAS

Map No. 73 Sec. 12 Twp. 16 R. 14WWell No. 3 Schneider "A"

Shell

Company

Contractor

## SECTION PLAT

NE SE

330 Ft. from N. Line

Ft. from S. Line

330 Ft. from E. Line

Ft. from W. Line

|  |  |  |   |
|--|--|--|---|
|  |  |  |   |
|  |  |  |   |
|  |  |  | 0 |
|  |  |  |   |

Location \_\_\_\_\_

Rig up \_\_\_\_\_

Drilling and Remarks:

*4000 acid**POT 3017*

## RECORD

Cased 7 in. 3334 ft.Sand Arb 3333

Gas \_\_\_\_\_

Oil \_\_\_\_\_

Total Depth 3348

## PRODUCTION

1st 24 hrs. Nat. \_\_\_\_\_

1st 24 hrs. after shot \_\_\_\_\_

Gas \_\_\_\_\_ Cu. Ft.

Dry Hole \_\_\_\_\_

Abandoned \_\_\_\_\_

Date


SEP 21 1938

*Hatfield*  
*By: Paul*

Scout

O. W. P. B.

County Barton State Kansas  
 Sec. 12 (Blk. Twp.) 16 (Sur. Rge.) 14W Map No. \_\_\_\_\_  
 Operator Shell Oil Co.  
 Well No. 3 Farm Schneider (A)  
 Elev. 1916 Location NE NE SE

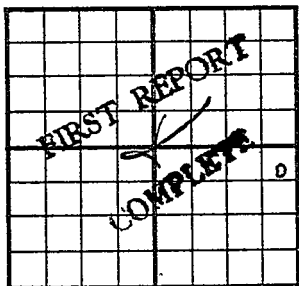

330 Ft. From N Line SE  
330 Ft. From E Line Quarter  
 Ist. Report JUN 1 8 1952  
JUN 1 8 1952  
 Completion \_\_\_\_\_  
 Remarks O. W. P. B.

Spudding Date \_\_\_\_\_

Drlg. Data

Lans 3104 Arb 3334 Prod OTD 3348 7" @ 333

CO 3333 12/3330/-33 VSSO 250A B/21 galw

4 hrs. DO 3336 SW 250A S/78 Bw plus SSO

3 hrs. PB 3143 28/3103-10 S.O. 3000A

P/ 19 Bo plus 1 Bwpd Comp.

J. G. McGEHEE