


Section 20 Township 14 Range 13W

Well No. #2, Opdycke

Company Jones & Shelborne

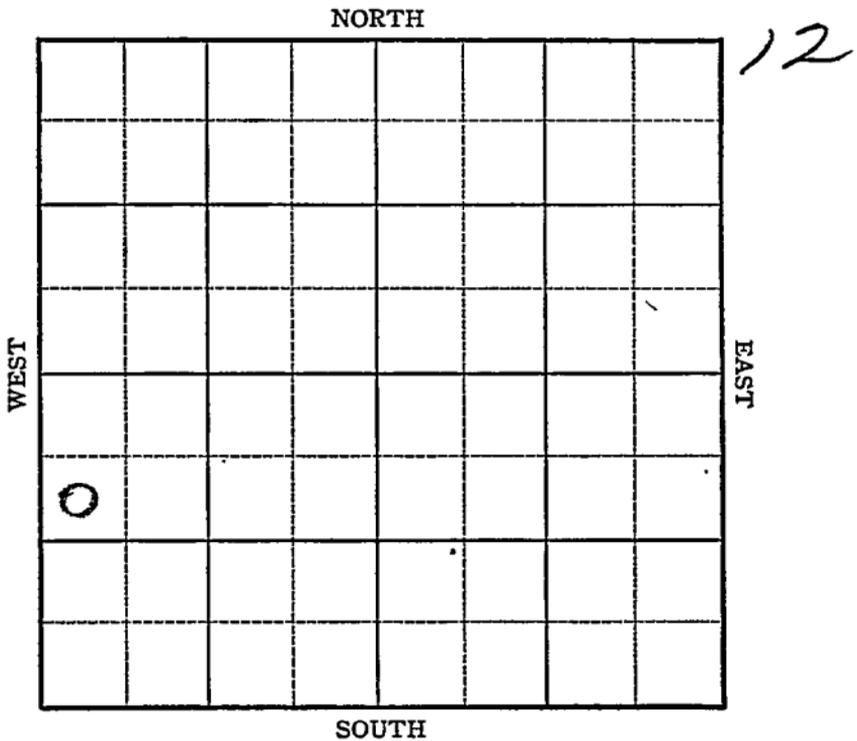

Sec. 20 Twp. 14 R. 13W

Well No. #2 Opdycke Farm
Jones & Shelborne Company

Hall-Gurney


990 Ft. from N. Line

_____ Ft. from S. Line

_____ Ft. from E. Line

330 Ft. from W. Line

SW NW SW

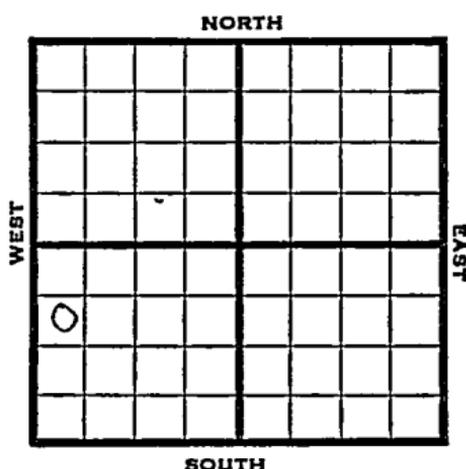

1946 Elev. 1783 REPORT

- 4/17 Location
- 4/23 "
- 5/1 15" @ 457
Drlg 640'
- 5/7 Anhy 745
13" @ 750
Drlg 1565'
- 5/14 10" @ 2022'
Drlg 2125'
- 5/21 8" @ 2500
Iopeka 2635
Drlg 2640'
- 5/29 SO 2675-2680
Dodge 2884
Lans. 2932
7" @ 3040'
Drlg. 3050'
- 6/5 Gorham 3200
TD 3206
2400' oil 12 hrs.
5" @ 3301 WOC
- 6/12 TD 3207'
Swb 30 oil & W in 6 hrs.
- 6/18 Arb 3202'

OVER

1946

6/26 Gorham 3200
Arb. 3202
5" @ 3201
TD 3207'
Pump 30 Pot.
Grav. 39.7

COMPLETED

KANSAS Kansas Pool Name Hall-Gurney PoolMap No. 12 Sec. 20 Twp. 14 R. 13WWell No. 2 OpdyckeJones & Shelborne Company**COMPLETED**

Contractor

SW NW SW

E. 1783
SECTION PLAT990 Ft. from N. Line Ft. from S. Line Ft. from E. Line330 Ft. from W. Line

0			

Russell County

Location _____

Rig up _____

Drilling and Remarks:

Gr karn 3200Ar 32025" 3201Pump 30 ft3202**RECORD**

Cased _____ in., _____ ft.

Sand _____

Gas _____

Oil _____

Total Depth 3207**PRODUCTION**

1st 24 hrs. Nat. _____

1st 24 hrs. after shot _____

Gas _____ Cu. Ft.

Dry Hole _____

Abandoned _____

Date

JUN 26 1946 19S. J. LEWIS Scout