


Section 12 Township 16 Range 14W

Well No. 2 Sausen "B"

Company Shell

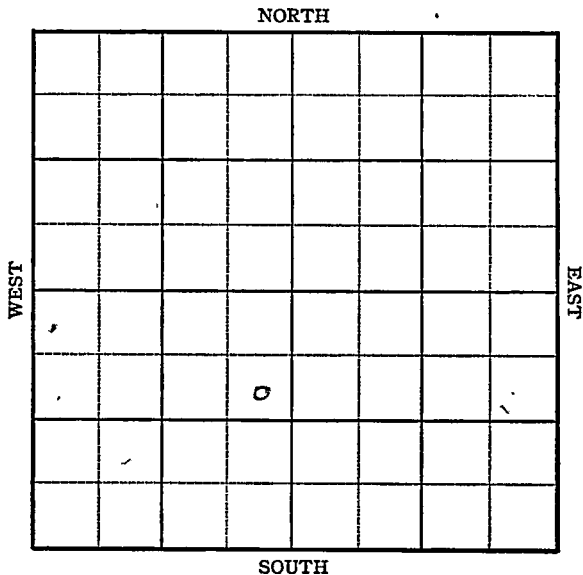

Sec. 12 Twp. 16 R. 14-W

Well No. #2 Sausen "B" Farm

Shell


Company

995 Ft. from N. Line

Ft. from S. Line

330 Ft. from E. Line

Ft. from W. Line

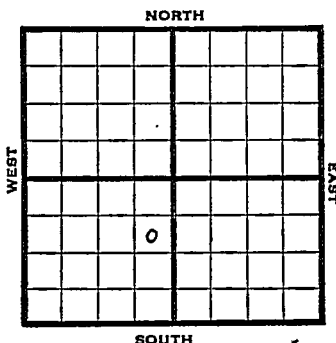

SE NE SW

1945 Elev. 1908' REPORT

11/14 Location

11/21 "

11/28 8" @ 650' WOC

12/5 Drlg. 2272

12/12 Arb. 3324

TD 3326

4" @ 3325 RUST

12/20 Drlg. 3339' S 0

12/29 T.D. 3365' 4000 acid.

Swab 7½ oil in 2 hours, 6% BS.

1946

1/10 T.D. 3390' Swab 10 oil & 35 water.

1/17 " " "

1/24 " " "

1/31 " " "

2/6 Arb. 3324
4" @ 3325
5000 acid.
TD 3390
Pump 22 oil plus 135 wtr. Pot.
Grav. 39.0

COMPLETED

Kansas Pool Name Trapp

Map No. 43 Sec. 12 Twp. 16 R. 14W

Well No. 2 Sausen "B"

Shell _____ Company _____

FIRST REPORT Contractor _____

SE NE SW

SECTION PLAT

995 Ft. from N. Line

_____ Ft. from S. Line

330 Ft. from E. Line

_____ Ft. from W. Line

Barton County

Location X

Rig up _____

Drilling and Remarks:

RECORD

Cased _____ in., _____ ft.

Sand _____

Gas _____

Oil _____

Total Depth _____

PRODUCTION

1st 24 hrs. Nat. _____

1st 24 hrs. after shot _____

Gas _____ Cu. Ft.

Dry Hole _____

Abandoned _____

Date

NOV 14 1945 19

S. J. LEWIS Scout

KANSAS Kansas Pool Name Trapp

Map No. 23 Sec. 12 Twp. 16 R. 14W

Well No. 2 Sausen "B"

Shell Company

COMPLETED

Contractor

SE NE SW

E. 1908
SECTION PLAT

995 Ft. from N. Line

 Ft. from S. Line

330 Ft. from E. Line

 Ft. from W. Line

Barton County

Location _____

Rig up _____

Drilling and Remarks:

*Core 3324
4" @ 3325
5000 acid*

*Pump 2201 + 135 Water
[Signature]*

39° G

RECORD

Cased _____ in, _____ ft.

Sand _____

Gas _____

Oil _____

Total Depth 2890

PRODUCTION

1st 24 hrs. Nat. _____

1st 24 hrs. after shot _____

Gas _____ Cu. Ft.

Dry Hole _____

Abandoned _____

Date

FEB 6 1945 19

S. J. LEWIS Scout