


Section 27 Township 13 Range 19W

Well No. 1 Dechant

Company Cities Service Oil

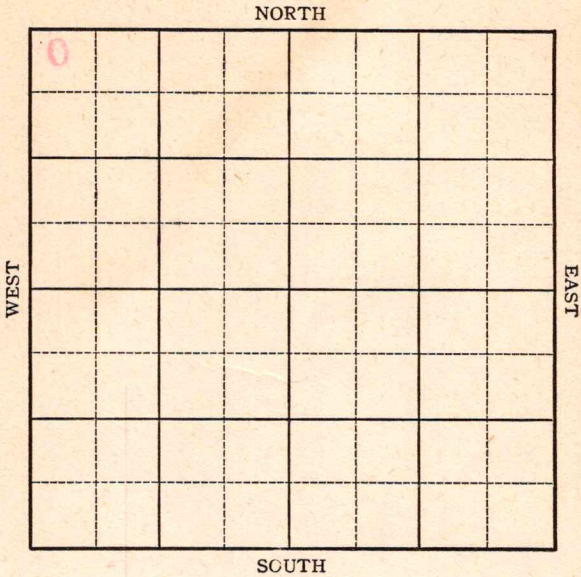

Sec. 27 Twp. 13 R. 19W

Well No. 1 Dechant Farm

Cities Service Oil Company


Wildcat

330 Ft. from N. Line

_____ Ft. from S. Line

_____ Ft. from E. Line

330 Ft. from W. Line

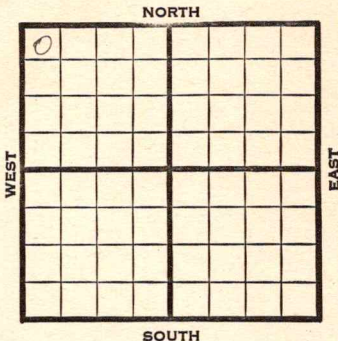

NW/c

1945

Elev. 2095

REPORT

6/6

RUR

6/27

Lans 3450

Simp 3789

Arb. 3805

TD 3825'

ABANDONED

Kansas Pool Name Wildcat

Map No. 70 Sec. 27 Twp. 13 R. 19W

Well No. 1 Dechant

Cities Service Oil Company

FIRST REPORT

Contractor

NW/c

SECTION PLAT

330 Ft. from N. Line

_____ Ft. from S. Line

_____ Ft. from E. Line

330 Ft. from W. Line

o			

Ellis County

Location _____

Rig up _____

Drilling and Remarks:
RUR

RECORD

Cased _____ in., _____ ft.

Sand _____

Gas _____

Oil _____

Total Depth _____

PRODUCTION

1st 24 hrs. Nat. _____

1st 24 hrs. after shot _____

Gas _____ Cu. Ft.

Dry Hole _____

Abandoned _____

Date

JUN 6 1945

19

S. J. LEWIS

Scout

Kansas Pool Name Wildcat

Map No. 70 Sec. 27 Twp. 13 R. 19W

Well No. 1 Dechant

Cities Service Oil Company

ABANDONED Contractor

NW/c

E. 1.2095
SECTION PLAT

330 Ft. from N. Line

_____ Ft. from S. Line

_____ Ft. from E. Line

330 Ft. from W. Line

0			

Ellis County

Location _____

Rig up _____

Drilling and Remarks:

Leans 3450
Sump 3789
Le 3885

RECORD

Cased _____ in., _____ ft.

Sand _____

Gas _____

Oil _____

Total Depth 3825

PRODUCTION

1st 24 hrs. Nat. _____

1st 24 hrs. after shot _____

Gas _____ Cu. Ft.

Dry Hole _____

Abandoned _____

Date

JUN 27 1945 19

S. J. LEWIS Scout